

Name Timothy J. Deleaney

Service No. 109

Address #26 WEBSTER RD.

LOT 42

Location

Kind of Pipe

Size

Size of Main

~~Repair~~ ~~Renewal~~ ~~Extension~~ New Service Suburbanite #A389


Location

Date		Material	Amount	Total	Date		Amount
22/66	41'	6" Transite pipe			8-12-66	Deposit	125 00
					10-3-66	Paid by WITCH 50	11 63
							136 63
-17-66		Labor	50.65				
-22-66		Labor	18.43	69 08			
		10% O.H.	6 91	75 99			
	20'	6" Transite pipe @ .79		15 80			
	1	6" Elbow		4 09			
	300	Lbs Cold patch @ 5.00 per ton		75			
	3 1/2	Hrs. Trucking @ 3.00		10 50			
	3	Hrs. Shovel @ 6.50		19 50			
	1	Hr. Trailer		2 00			
	1	Hr. Roller		3 00			
	1	Hr. Compressor		5 00			
				136 63			

DATE _____

TOWN OF LEXINGTON — BOARD OF PUBLIC WORKS
SEWER DIVISION

Sketch of Service Here

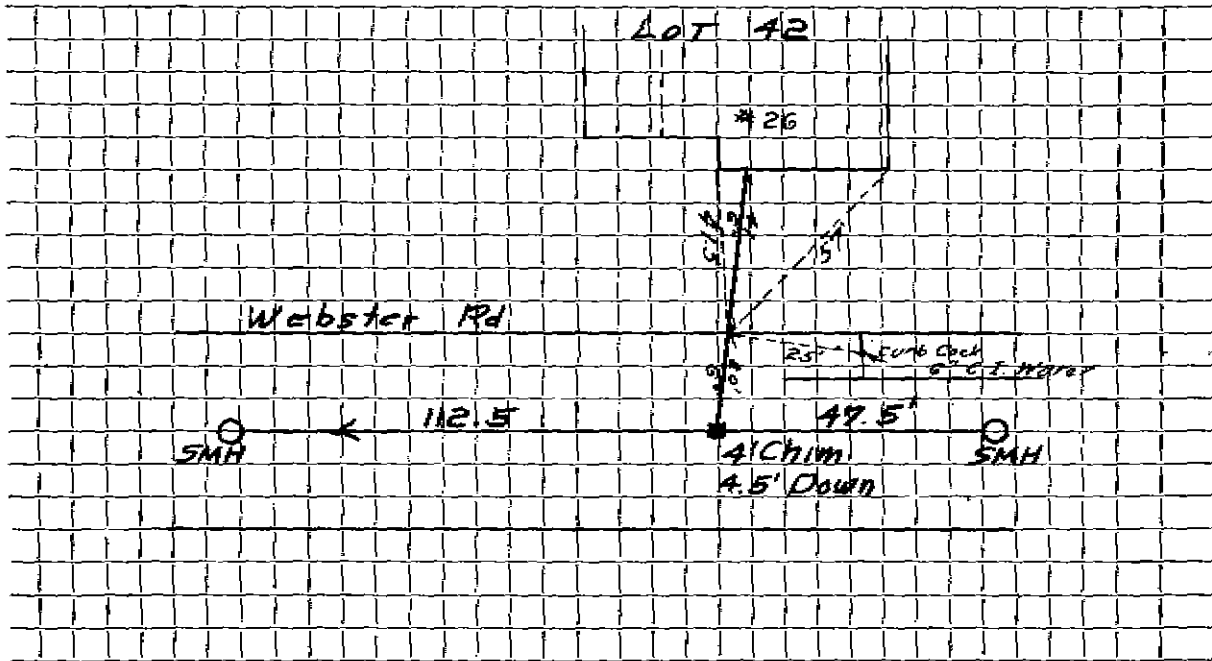

Connection made in Street. Work completed

Remarks:

b!