

Name **Edmund Tocci**Service No. **23**Address **#27 WEBSTER RD.****LOT 67**

Location

Kind of Pipe

Size

Size of Main

~~REPAIR SERVICE~~ — New ServiceWo # **8590**

Location

*Comm 5-18-64*


Date	Material	Amount	Total	Date	Amount
3-25-64	Labor	103 26		3-17-64	300 00
	10% O.H.	10 33	113 59	5-18-64	33 12
46'	6" transite pipe @.82		37 72		266 88
1	6" 90 ° Transite Elbow		4 09		
1	6" Service Saddle		5 25		
19½	Ton 1½" Stone @1.50		29 25		
20½	Ton Bank Gravel @.85		17 43		
1	Bag Cement		1 55		
21	X 3 Patch		21 00		
4	Hrs. Town Shovel @6.50		26 00		
3	Hrs. Trucking @3.00		9 00		
2	Hrs. Pumping @1.00		2 00		
			266 88		

DATE \_\_\_\_\_

TOWN OF LEXINGTON — BOARD OF PUBLIC WORKS

SEWER DIVISION

Sketch of Service Here

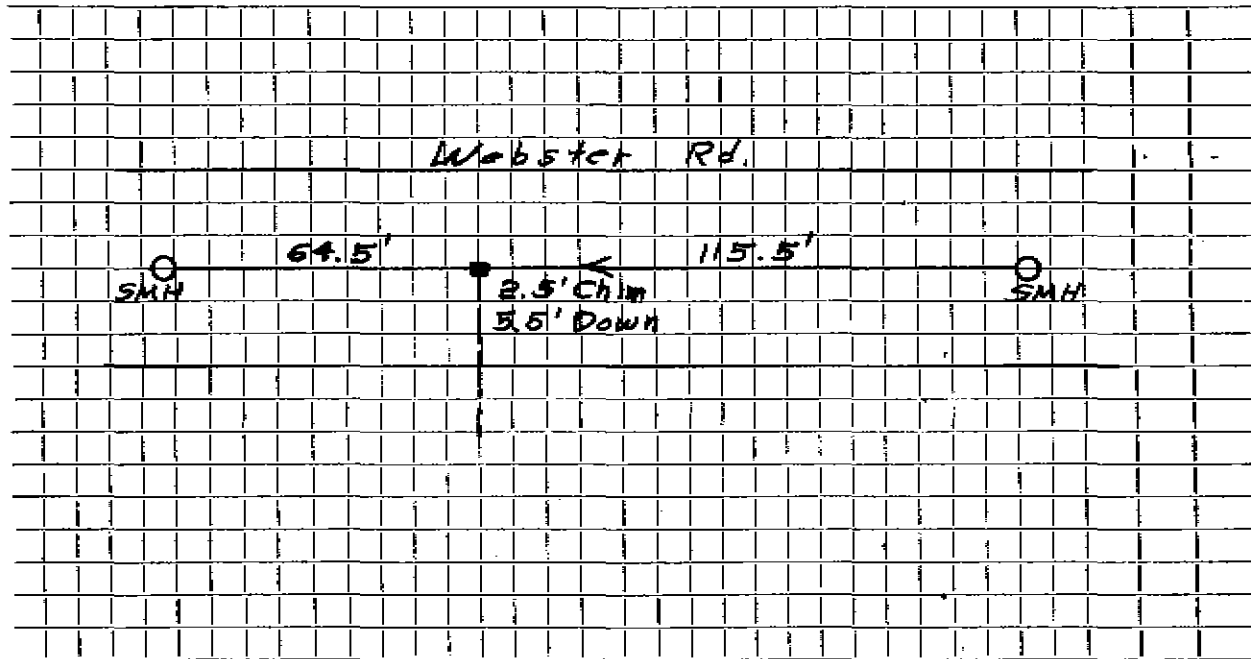

Connection made in ..... Street. Work completed .....

Remarks: .....

.....

.....