

Name Vahan Terzian

Service No. 213

Address #28 WEBSTER RD.

Location

Kind of Pipe

Size

Size of Main

~~Duplex Adapter~~ New Service

WO# 8367

Location


Comm 5-18-64

Date	Material	Amount	Total	Date	Amount
2-11-64	Labor	64.60		12-4-63	350.00
4-28-64	"	19.50	84 10	5-18-64	121.37
	10% O.H.	8 41	92 51		228.63
91	6" Transite Pipe @.82		74 62		
	1 Duplex Adapter		1 62		
	2 11 1/2" Transite Elbow @2.35		4 70		
	2 11 1/2" Transite Bend @4.09		8 18		
	3X13 Patch		13 00		
	3 Hrs. Trucking @3.00		9 00		
	2 Hrs. Town Shovel @6.50		13 00		
	4 Yards Loam @3.00		12 00		
			228 63		

DATE _____

TOWN OF LEXINGTON — BOARD OF PUBLIC WORKS
SEWER DIVISION

Sketch of Service Here

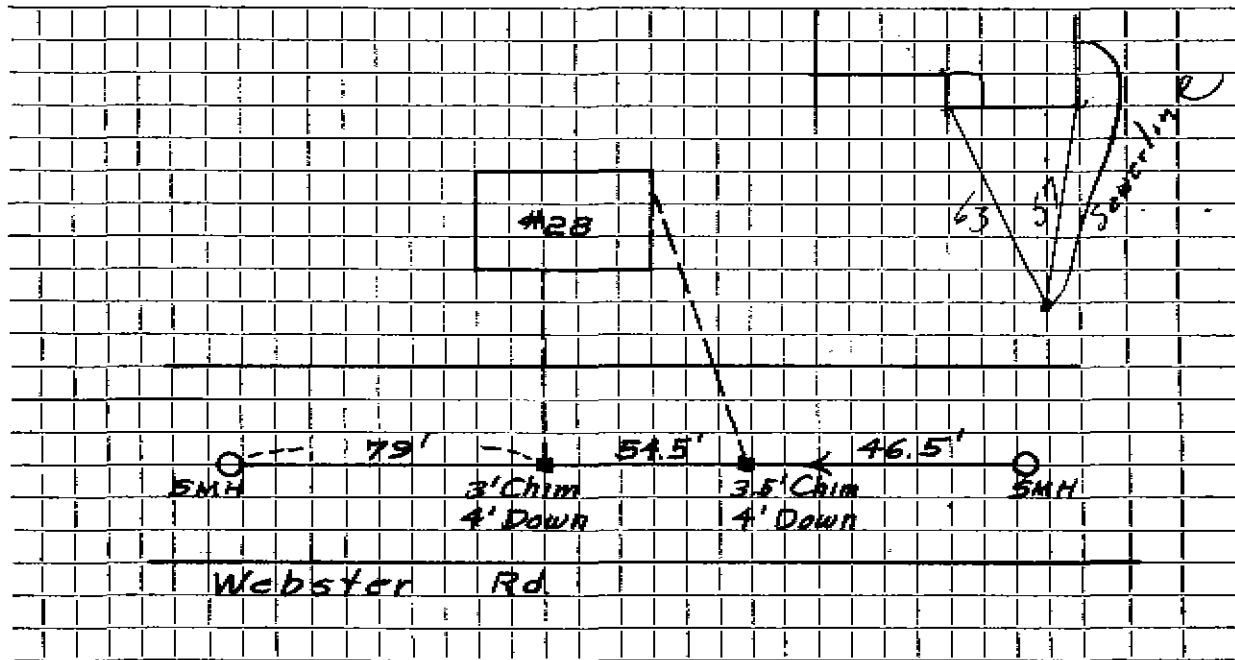

Connection made in Street. Work completed

Remarks:
.....
.....