

Name Norman Prändergast

Service No. 254

Address 29 Webster Road

Location

Kind of Pipe

Size

Size of Main

~~XXXXXXXXXXXX~~ New Service W.O. #11442

Levy Trivia Permit #A157

Location

JUN 27 1966


Date	Material	Amount	Total	Date	Amount
26-65	Labor 118.90			12/13/65	125 00
28-66	Patching 15.82				
29-66	Patching 23.88	158 60			
	10% O.H.	15 86	174 46		
	20' 6" Transite Pipe @ .82		16 40		
	1/2 Bag Cement @ 1.50		75		
	2 Doz. Brick @ 4.20 per 100		1 02		
	7 Ton Gravel @ 1.10		7 70		
	2 1/2 Ton hot top @ 5.50		13 75		
	2 Hrs Shovel @ 6.50		13 00		
	1 Hr. Loader		4 00		
	2 Hrs. Truck @ 3.00		6 00		
	1 Hr. Roller		3 00		
	1 Hr. small trailer		2 00		
	1 Hr. Compressor		5 00		
5	36' 6" Transite pipe		247 08		
					<i>Bill sent 122.08</i>

DATE _____

TOWN OF LEXINGTON — BOARD OF PUBLIC WORKS

SEWER DIVISION

Sketch of Service Here

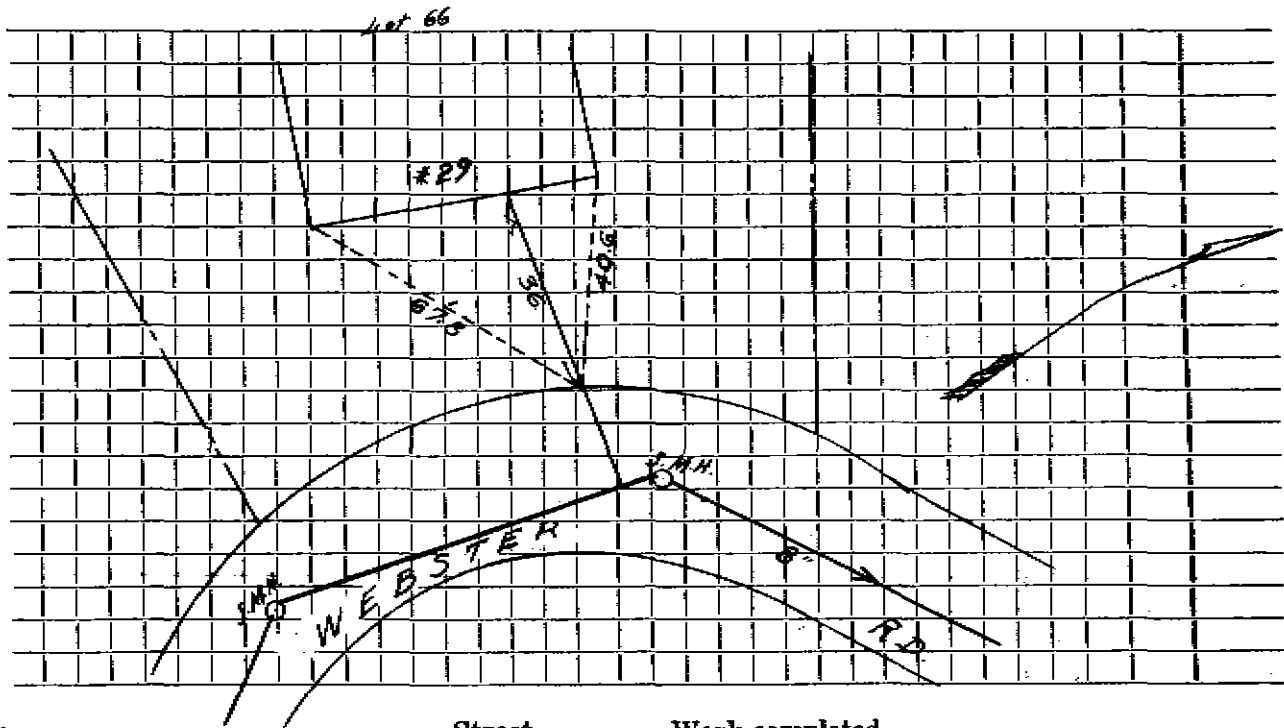

Connection made in Street. Work completed

Remarks:

.....

.....

Name

Service No.

Address # 29 WEBSTER RD.

LOT 66

Location

Kind of Pipe

Size

Size of Main

Repair—Renewal—New Service

Location


Date		Material	Amount	Total	Date		Amount	
					7-12-66	<i>Paid</i>	122	08

DATE _____

TOWN OF LEXINGTON — BOARD OF PUBLIC WORKS

SEWER DIVISION

Sketch of Service Here

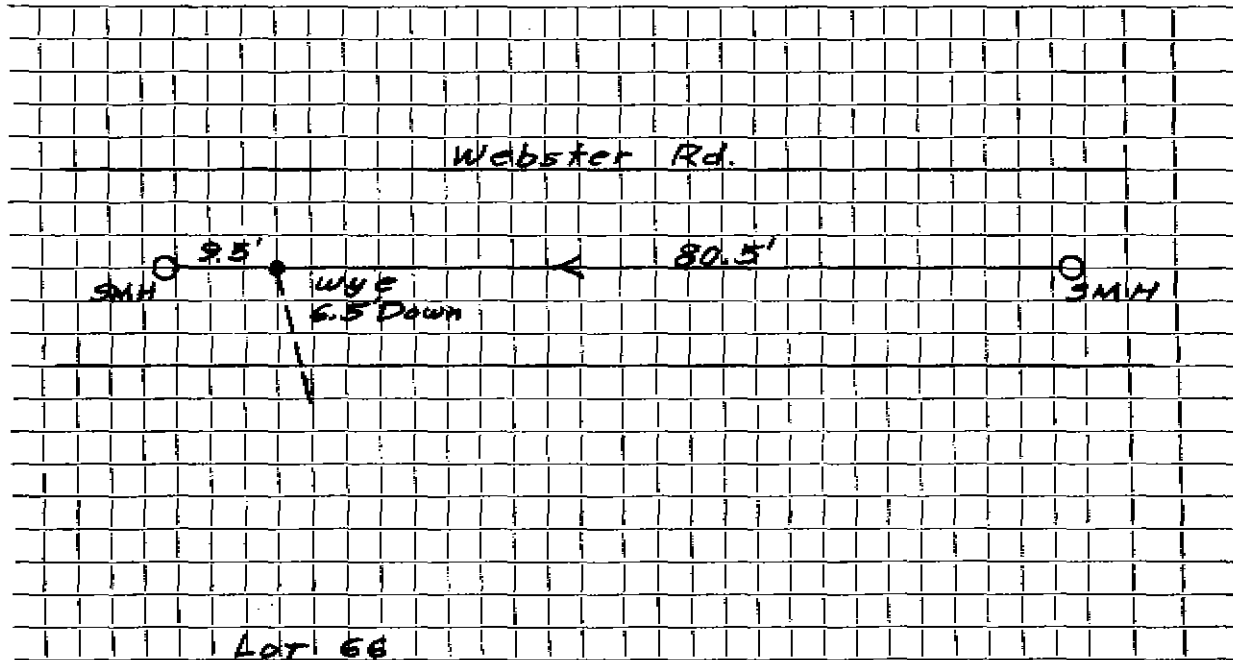

Connection made in Street. Work completed

Remarks:

.....

.....