


DATE B.26.98

TOWN OF LEXINGTON — BOARD OF PUBLIC WORKS
SEWER DIVISION

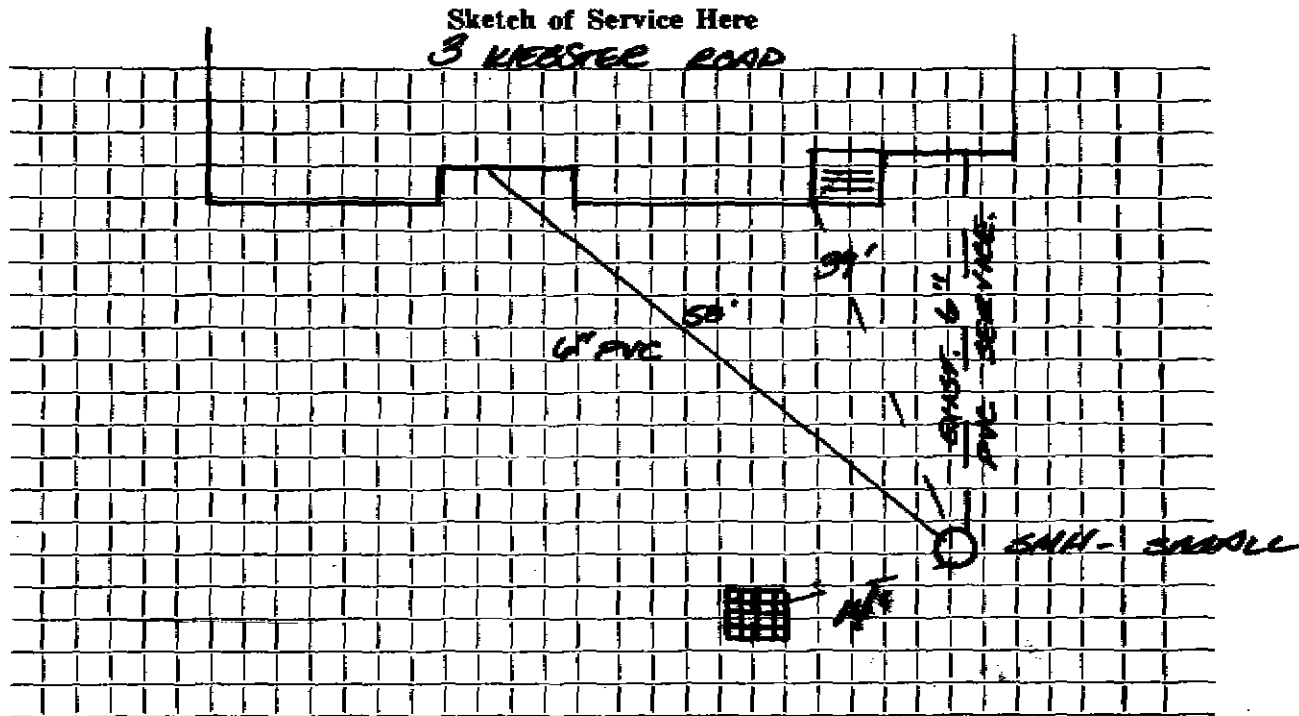

Connection made in WEBSTER ROAD Street. Work completed MARCOE BEGS.

Remarks:

.....


.....

DATE _____

TOWN OF LEXINGTON — BOARD OF PUBLIC WORKS

SEWER DIVISION

Sketch of Service Here

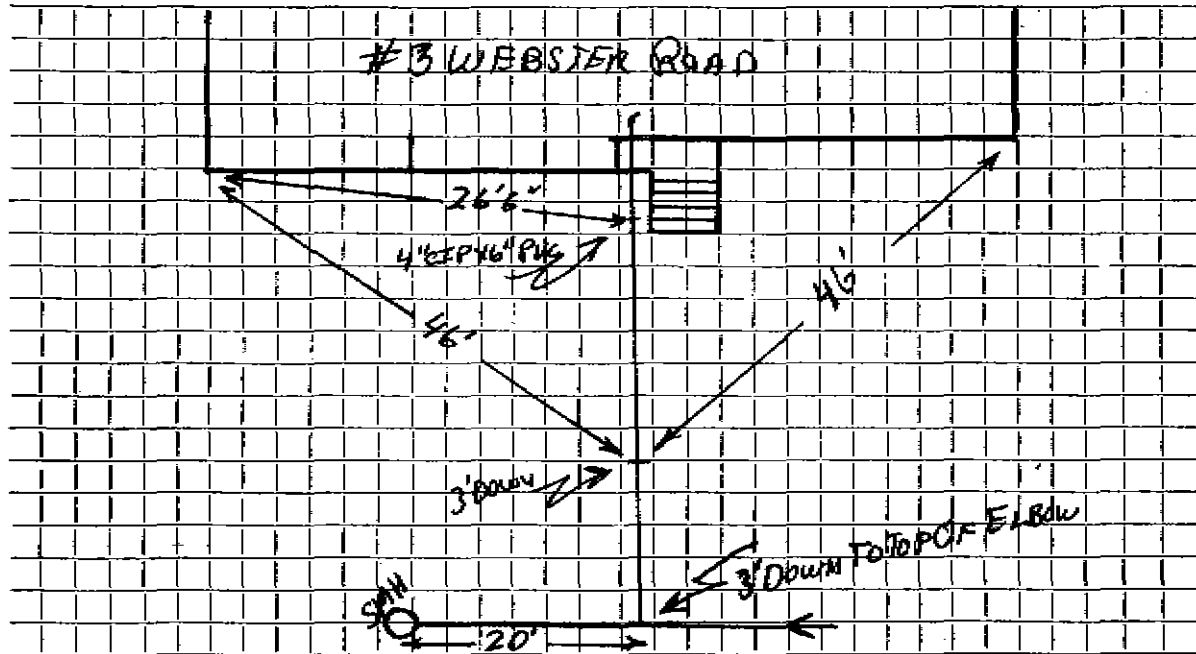

Connection made in WEBSTER ROAD..... Street. Work completed MARCH 22, 1985.....

Remarks:

.....

.....

Name

Service No.

Address #3 WEBSTER ROAD

Location

Kind of Pipe

Size

Size of Main

Repair—Renewal—New Service

Location

Date

Material

Amount

Total

Date

Amount


Save this card per Jim Mc

DATE _____

TOWN OF LEXINGTON — BOARD OF PUBLIC WORKS

SEWER DIVISION

Sketch of Service Here

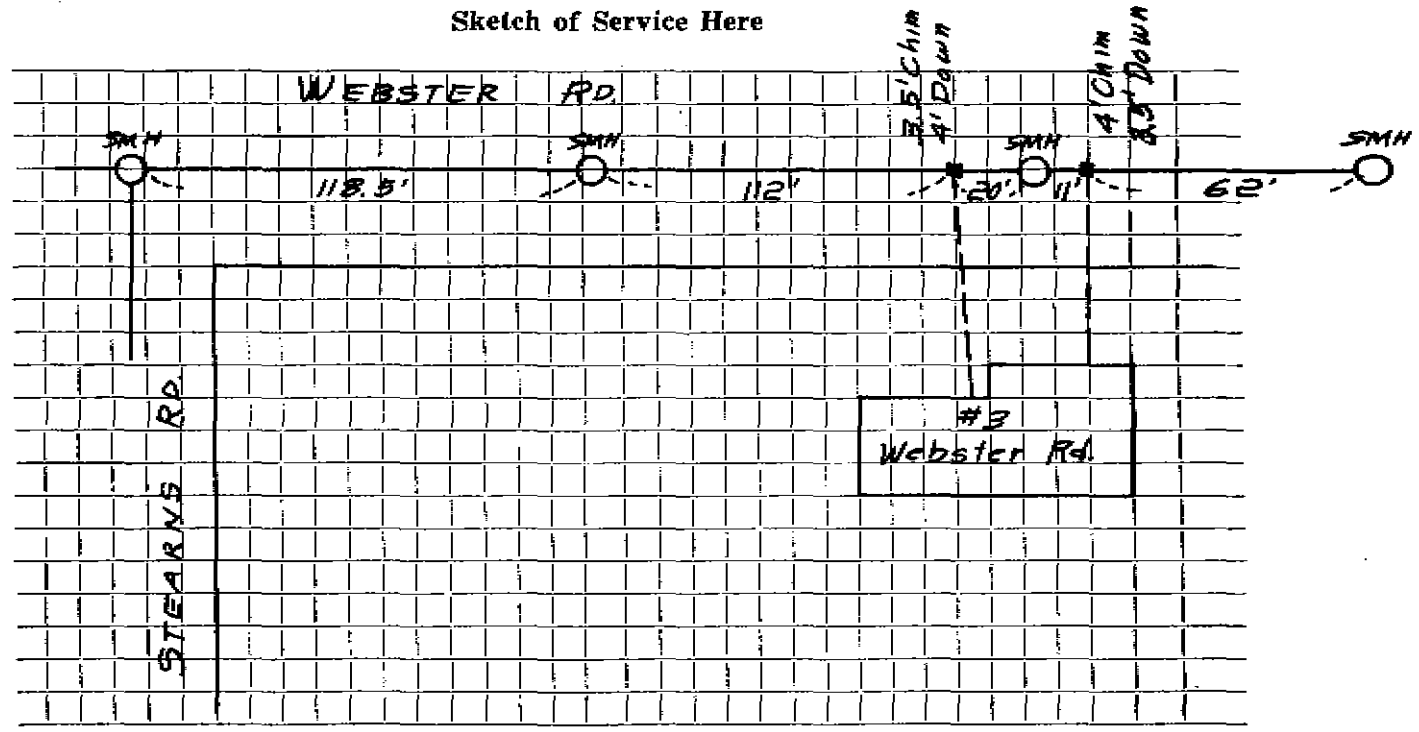

Connection made in Street. Work completed

Remarks:
.....
.....