

Name Francis D. Peters

Service No. 214

Address #31 WEBSTER RD.

Location

Kind of Pipe

Size

Size of Main

~~ROAD REPAIR~~ New Service

WO # 8365

Location

Cem 5-18-64


Date	Material	Amount	Total	Date	Amount
12-10-63	Labor	88.08		12-5-63	350 00
4-28-64	"	19.50	107 58	5-18-64	78 25
	10% O.H.	10 76	118 34		271 75
60'	6" Transite Pipe @.82		49 20		
13	3/4 Ton Gravel @1.10		15 12		
1	90° Transite Elbow		4 09		
4	Ton 3/4" Stone @1.50		6 00		
4	Hrs. Town Shovel @6.50		26 00		
4	Hrs. Trucking @3.00		12 00		
1	Hr. Loader @5.00		5 00		
2	Hrs. Pumping @3.00		6 00		
18	X 3 Patch		18 00		
4	Yds. Loam @3.00		12 00		
			271 75		

DATE: _____

TOWN OF LEXINGTON — BOARD OF PUBLIC WORKS

SEWER DIVISION

Sketch of Service Here

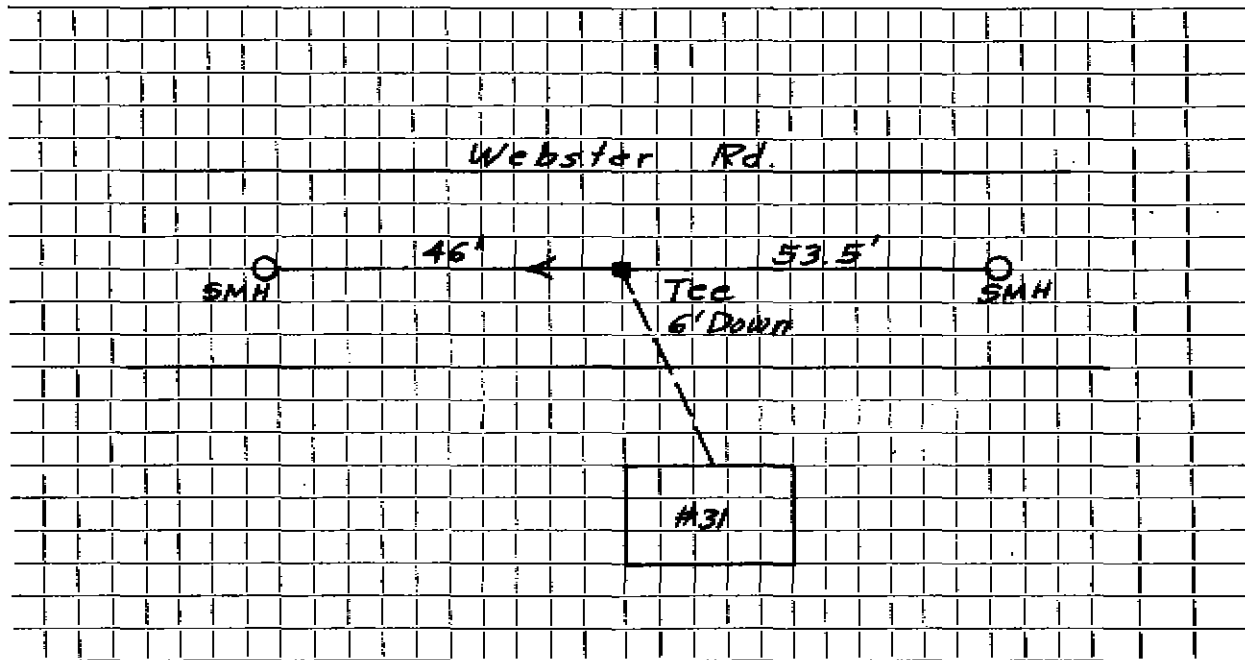

Connection made in Street. Work completed

Remarks:

.....

.....