

Name **William Alexson**Service No. **153**Address **<sup>32</sup> Webster Road**

Location

Kind of Pipe

Size

Size of Main

~~Reservoir~~ - New Service

W.O. #8265


Location **MAR 23 1964**

Date		Material	Amount		Total		Date	Amount	
/1/63		Labor	104	09			<i>11-23-63</i>	<i>Deposit</i>	300 00
/4/63		Labor	56	56			<i>5-15-64</i>	<i>Paid</i>	<u>24 91</u>
			160	65					324 91
		10% Overhead	16	07	176	72			
	80'	6" Transite pipe @ .82			65	60			
	1	11 $\frac{1}{2}$ " Transite Bend			4	09			
	12	* 3 Patch			12	00			
	8	yds. Loam @ 3.00			24	00			
	3	hrs. Town Shovel @ 6.50			19	50			
	5	hrs. Trucking @ 3.00			15	00			
	1	hr. Loader			5	00			
	1	hr. Trailer			3	00			
					324	91			
									<i>Deposit 24.91</i>

DATE \_\_\_\_\_

TOWN OF LEXINGTON — BOARD OF PUBLIC WORKS  
SEWER DIVISION

Sketch of Service Here

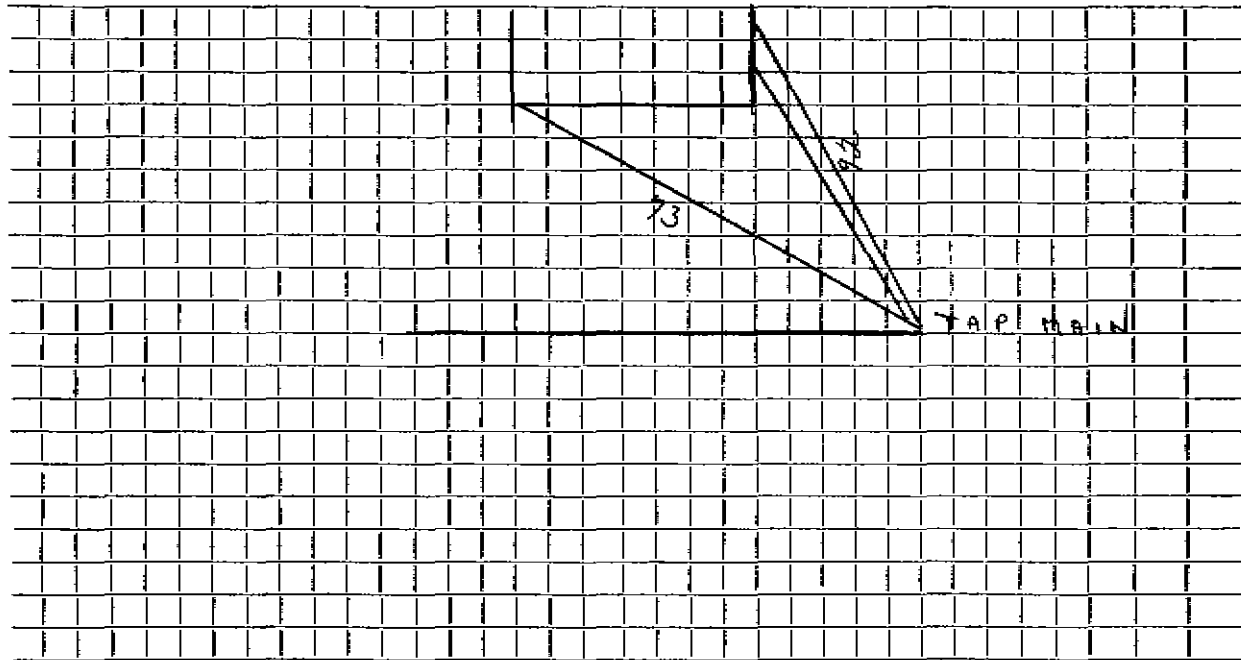

Connection made in ..... Street. Work completed .....

Remarks: .....

.....

.....

**Name**

**Service No.**

**Address** # 32 WEBSTER RD.

**Location**

**Kind of Pipe**

**Size**

**Size of Main**

**Repair—Renewal—New Service**

**Location**

**Date**

**Material**

**Amount**

**Total**

**Date**

**Amount**


Date	Material	Amount	Total	Date	Amount

DATE \_\_\_\_\_

TOWN OF LEXINGTON — BOARD OF PUBLIC WORKS

SEWER DIVISION

Sketch of Service Here

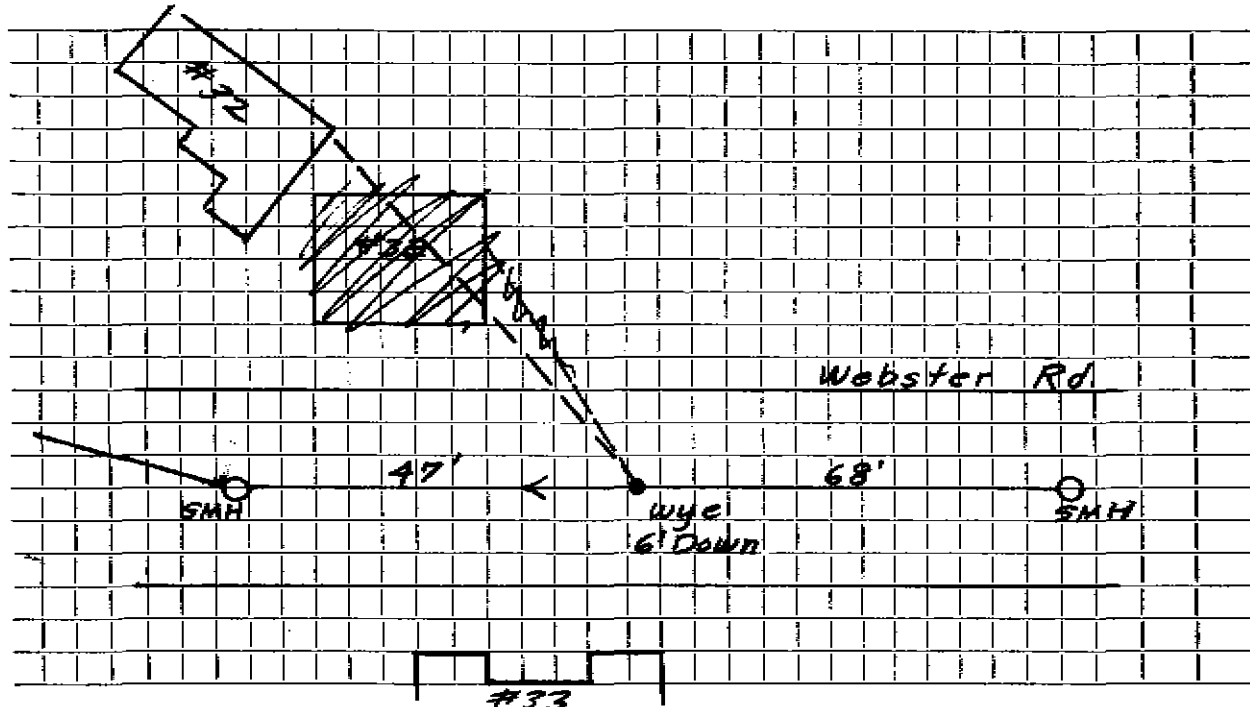

Connection made in ..... Street. Work completed .....

Remarks: .....

.....

.....