




DATE Sep, 2022

TOWN OF LEXINGTON — BOARD OF PUBLIC WORKS  
SEWER DIVISION

Sketch of Service Here  
33 Webster Rd

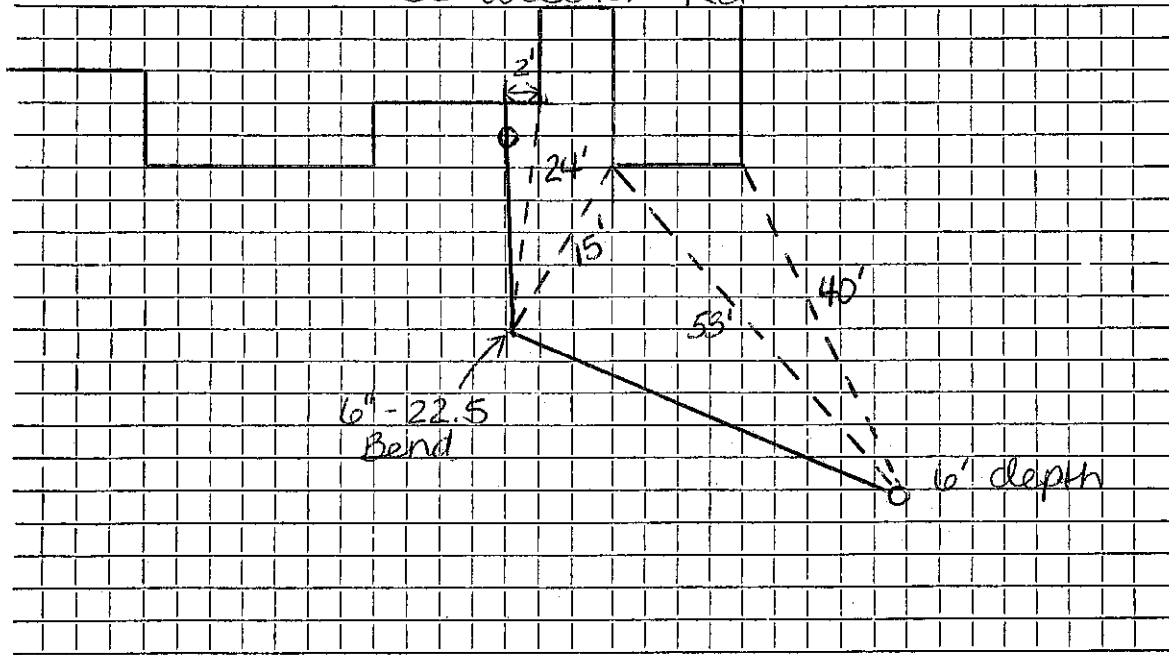

Connection made in ..... Street. Work completed .....

Remarks: Installed by Iovino Excavating .....