

Name Michael H. Kalajian

Service No. 75

Address #34 WEBSTER RD.

Location

Kind of Pipe

Size

Size of Main

Repair—Renewal—New Service

W.O.#4950 Valeri #684

Location

MAR 18 1968


Date	Material	Amount	Total	Date	Amount
7-10-67	28' 6" Transite pipe			6-27-67	125 00
				4-16-68	3 36
6/27/67	Labor	48.12			128 36
6/30/67	Labor	14.76	62 88		
	10% O.H.	6 29	69 17		
	8 ton gravel @ 1.10		8 80		
	15' 6" transpipe @ .88		13 20		
	1 22 $\frac{1}{2}$ " bend		4 09		
	2 ton hot top @ 5.80		11 60		
	3 $\frac{1}{2}$ hrs. trucking @ 3.00		10 50		
	1 hr. shovel @ 6.50		6 50		
	$\frac{1}{2}$ hr. loader @ 4.00		2 00		
	$\frac{1}{2}$ hr. compressor @ 5.00		2 50		
			128 36		
					Bill sent 3.36

DATE \_\_\_\_\_

TOWN OF LEXINGTON — BOARD OF PUBLIC WORKS

SEWER DIVISION

Sketch of Service Here

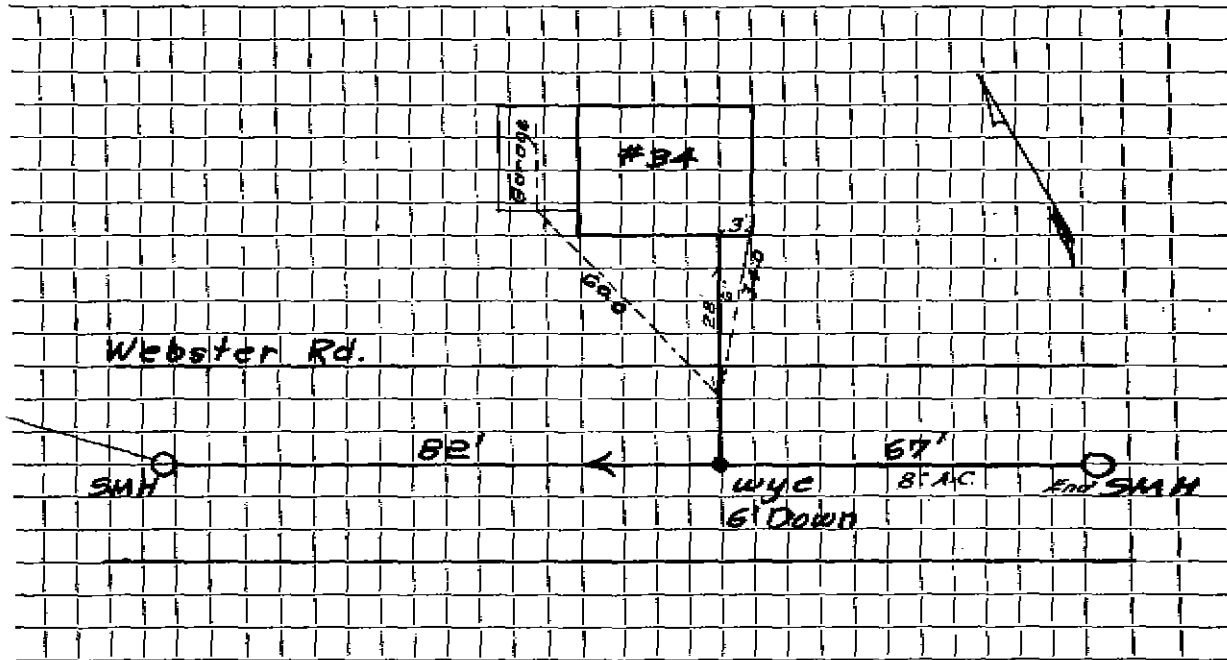

Connection made in ..... Street. Work completed .....

Remarks: .....

.....

.....