

Name **Maurice H. Connors, M.D.**

Service No. 134

Address #35 WEBSTER RD.

Location

Kind of Pipe

Size

Size of Main

~~Repair~~ ~~Renewal~~ ~~—~~ New Service

W.O. # 7100 Cont.

#1507
Lexington Sewerage

Location APR 6 1970


Date	Material	Amount	Total	Date	Amount
11/19/69	Labor		60 10	11-14-69	200 00
	10% O.H.		6 01	4-6-70	83 45
15'	6" Transitepipe .88		13 20		116 40
1	90o Elbow		4 09		
3	Ton 3/4 Stone 1.65		4 95		
1	Yd. Gravel		1 70		
1	Ton cold patch		5 85		
2	Hrs. Trucking 3.00		6 00		
1	" "		1 50		
2	" Shovel 6.50		13 00		
			116.40		
1-25-69	37' 6" Transite pipe				
	7' 4" Cast Iron pipe				

DATE _____

TOWN OF LEXINGTON — BOARD OF PUBLIC WORKS

SEWER DIVISION

Sketch of Service Here

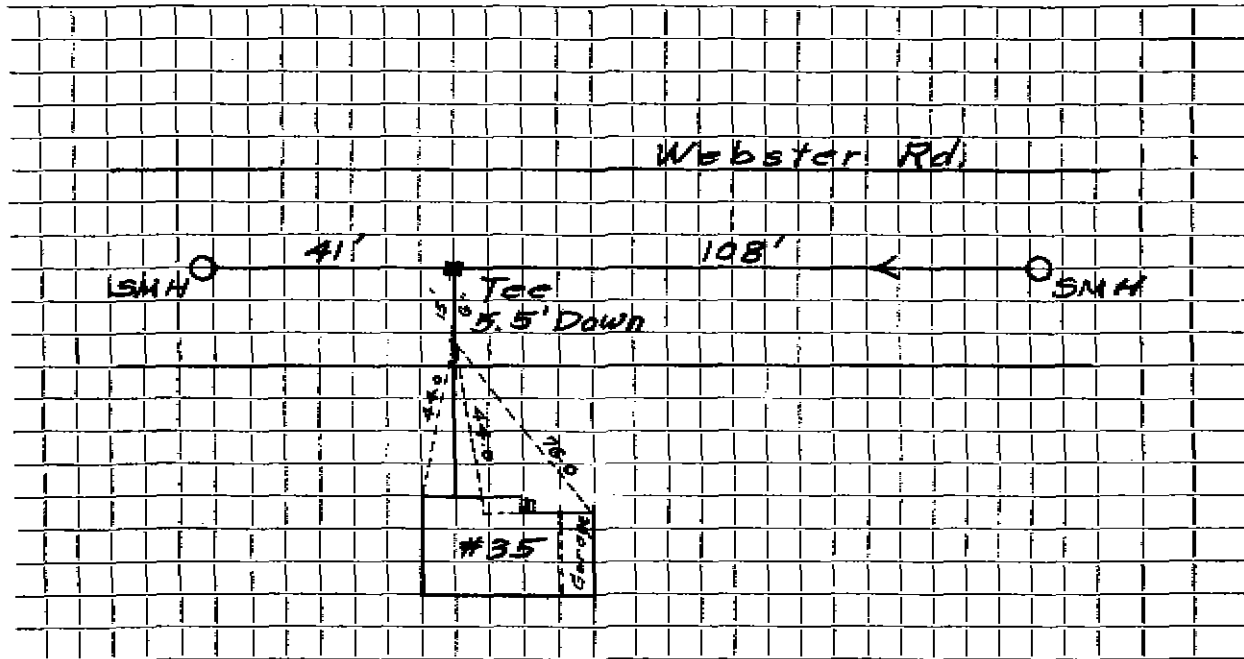

Connection made in Street. Work completed

Remarks:

.....

.....