


DATE _____

TOWN OF LEXINGTON — BOARD OF PUBLIC WORKS
SEWER DIVISION

Sketch of Service Here

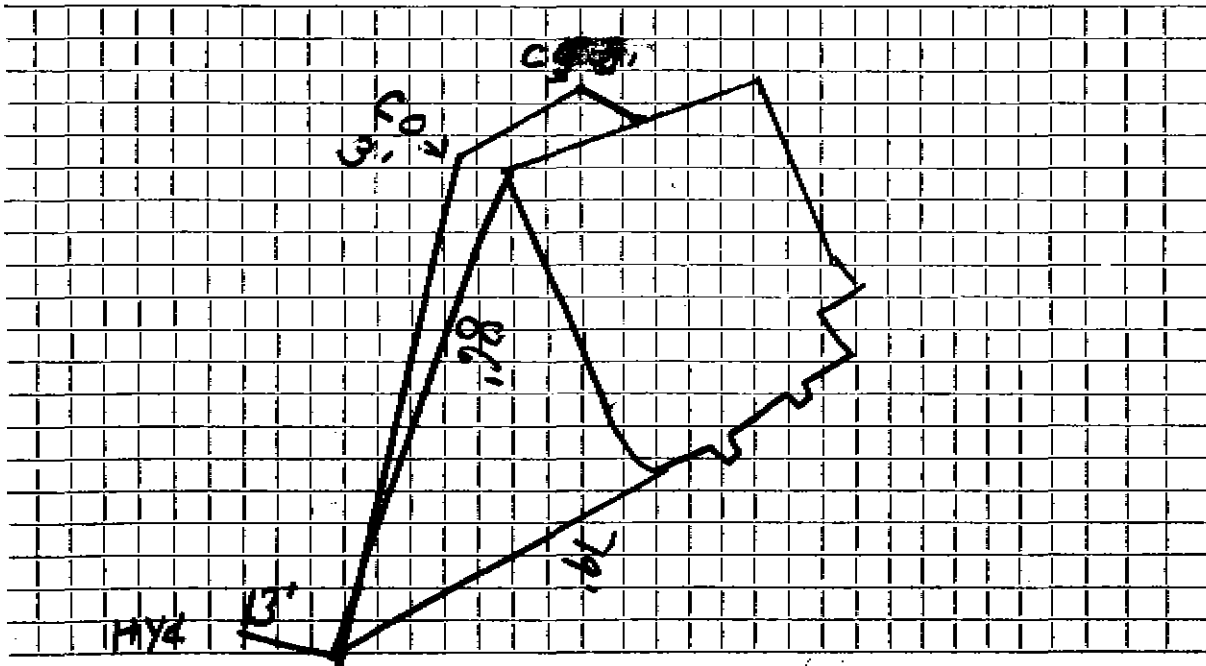

Connection made in Street. Work completed

Remarks:

Name

Service No.

Address

36 Webster Road

Location


Kind of Pipe

Size

Size of Main

Repair—Renewal—New Service

Location

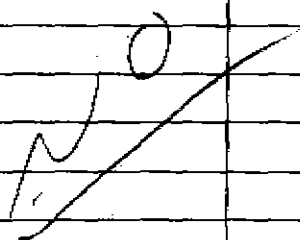
Date	Material	Amount	Total	Date	Amount
					

DATE _____

TOWN OF LEXINGTON — BOARD OF PUBLIC WORKS

SEWER DIVISION

Sketch of Service Here

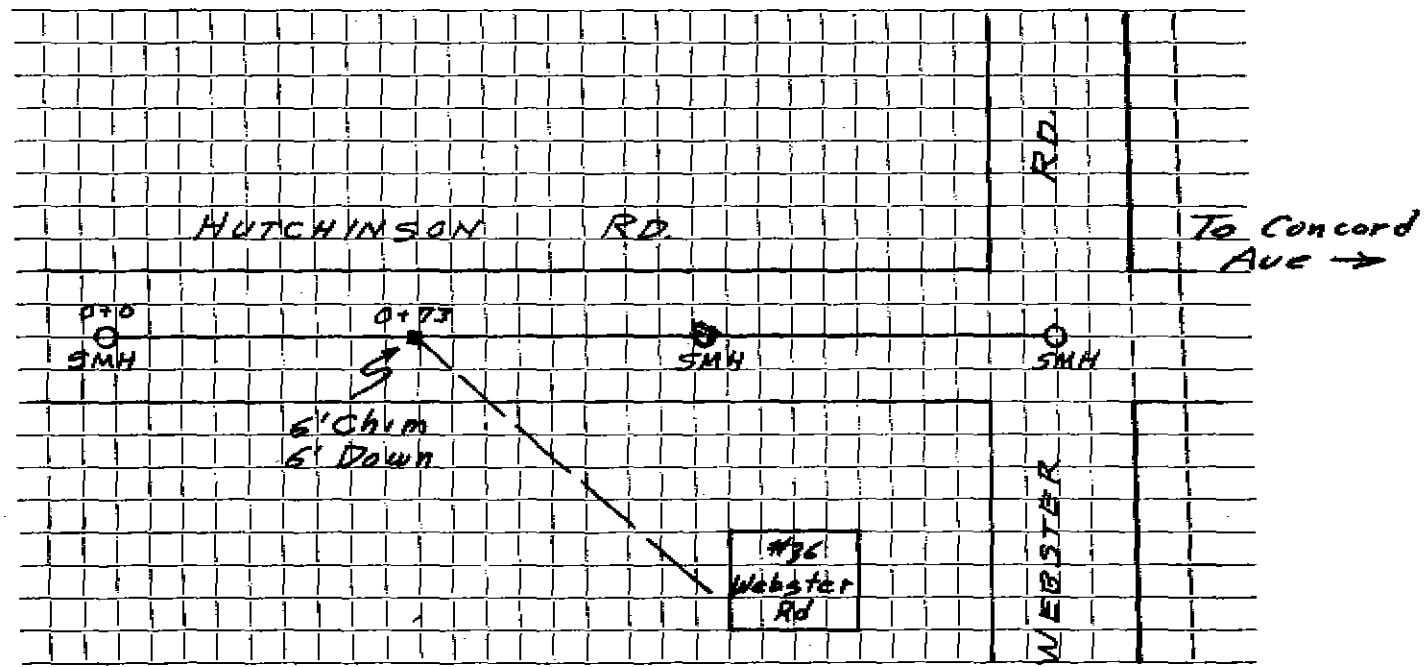

Connection made in Street. Work completed

Remarks:
.....
.....

Name Milton Gould

Service No. 25

Address 16 Webster Road

Location

AUG 6 1979

Kind of Pipe

Size

Size of Main

Depth—Renewal—Backhoe H.O. # 9403

Location


Date	Material	Amount	Total	Date	Amount
6/20/79	Labor	77.82		5-7-79	Deposit 200.00
	10% O.H.	7.78	85.60	8-4-79	Refund 81.65
1	4" Donut		3.25		118.35
4	Yds. Gravel @ 4.25		17.00		
2	Hrs. Trucking @ 3.00		6.00		
1	Hr. Backhoe		6.50		
			\$ 118.35		



TOWN OF LEXINGTON — BOARD OF PUBLIC WORKS
DATE _____

SEWER DIVISION

Sketch of Service Here

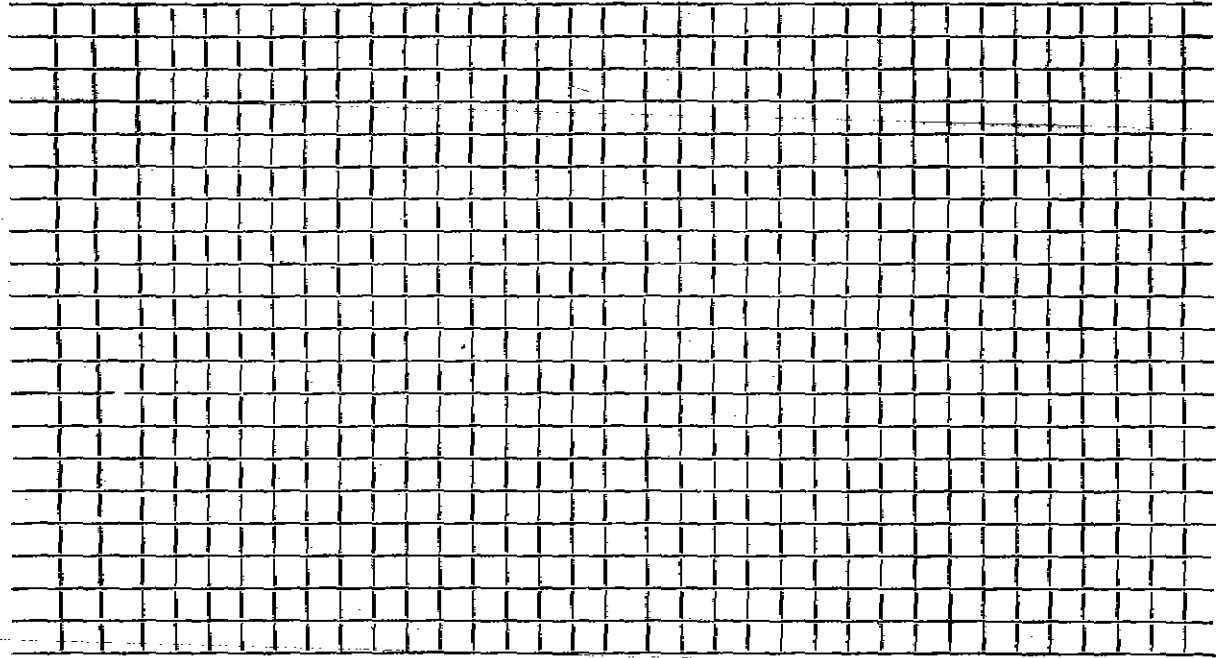

Connection made in Street. Work completed
Remarks:

Name **Milton Gould**

Service No. 74

Address **36 Webster Road**

Location

Kind of Pipe **Nicholas Bonanno**

Size

Size of Main

~~Basic Contract~~ **New Service Permit #315 W.O. #461**

Location **MAR 14 1966**


Date	Material	Amount	Total	Date	Amount
1/65	Labor	71.40		6-7-65	Deposit
	10% O.H.	7.14	78.54	3-31-66	Paid
	16' 6" Transite pipe @.82		13.12		138.61
	1/2 bag cement @1.50		.75		
	12 brick @4.20 per 100	<i>NO</i>	.52		
	16 x 3 Patch		16.00		
	2 hrs. Town Truck @3.00		6.00		
	7 1/8 ton Stone @1.50		10.68		
				<u>138.61</u>	
-65	83' 6" transite pipe				
					Bill sent 13-61

DATE _____

TOWN OF LEXINGTON — BOARD OF PUBLIC WORKS

SEWER DIVISION

Sketch of Service Here

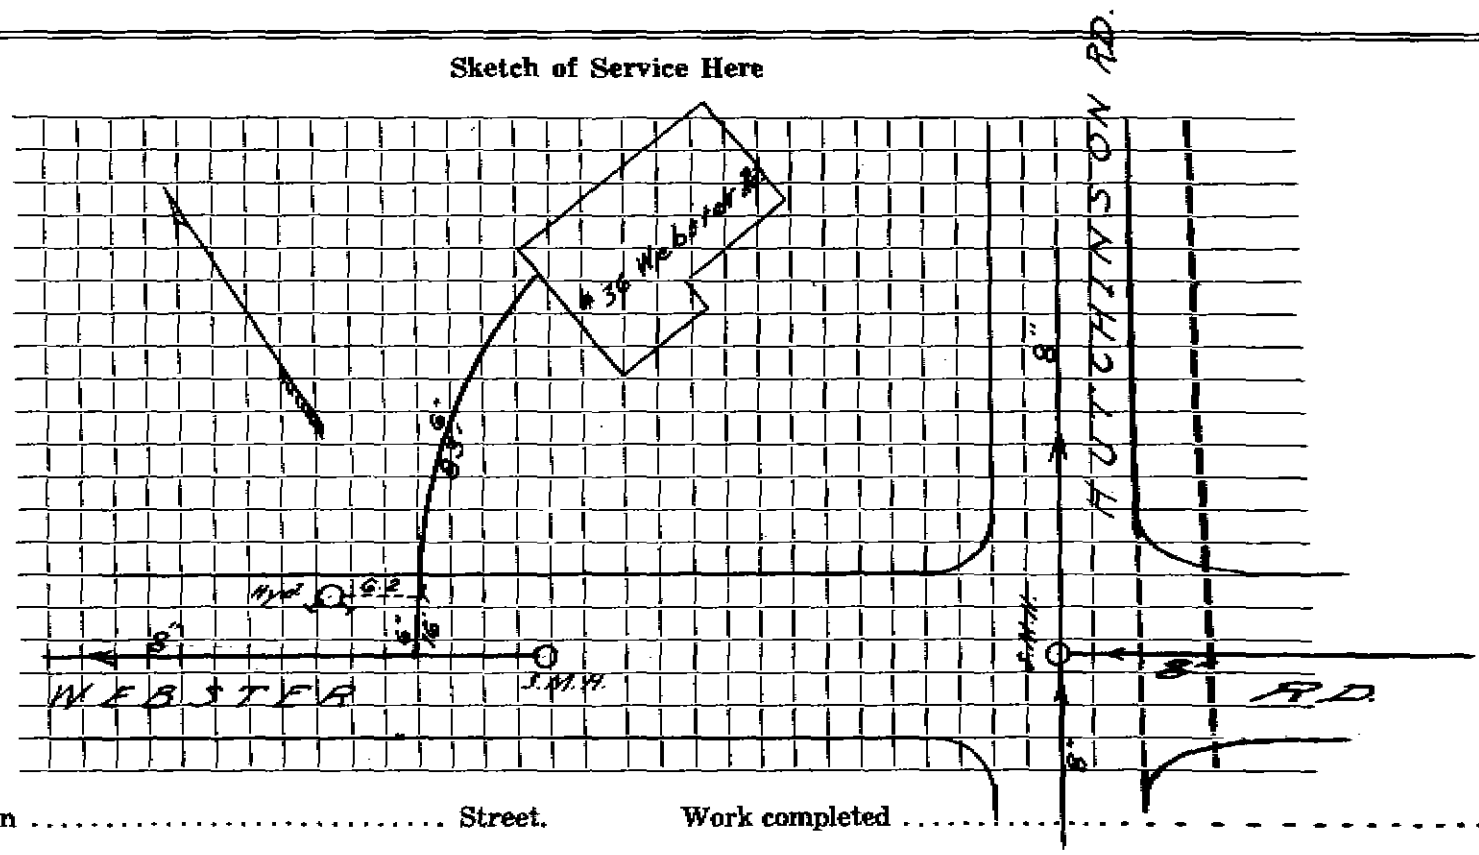

Connection made in Street. Work completed

Remarks:

.....

.....