

Name Norman Nicolson

Service No. 108

Address 37 Webster Road

Location

Kind of Pipe

Size

Size of Main

~~Repair~~ ~~Reconnect~~ New Service W.O. # 6929 Suburbanite #1488

Location DEC 22 1969


Date	Material	Amount	Total	Date	Amount
10/11/69	Labor	105 21		10-2-69	250 00
11/4/69	"	18 86	124 07	11-22-69	27 29
10%	C.H.		12 41		222 71
20'	6" Transite pipe .88		17 60		
1	90o Elbow		4 09		
1	6" Nipple		91		
1	Ton cold patch		5 85		
1 1/2	" hot top 5.85		8 78		
3 1/2	Hrs. trucking 3.00		10 50		
5	" shovel 6.50		32 50		
1/2	" compressor 5.00		2 50		
1/2	" roller 3.00		1 50		
	trailer		2 00		
			222 71		
0-17-69	57' 6" Transite pipe				
	10' 4" Cast Iron Pipe				

DATE \_\_\_\_\_

TOWN OF LEXINGTON — BOARD OF PUBLIC WORKS

SEWER DIVISION

Sketch of Service Here

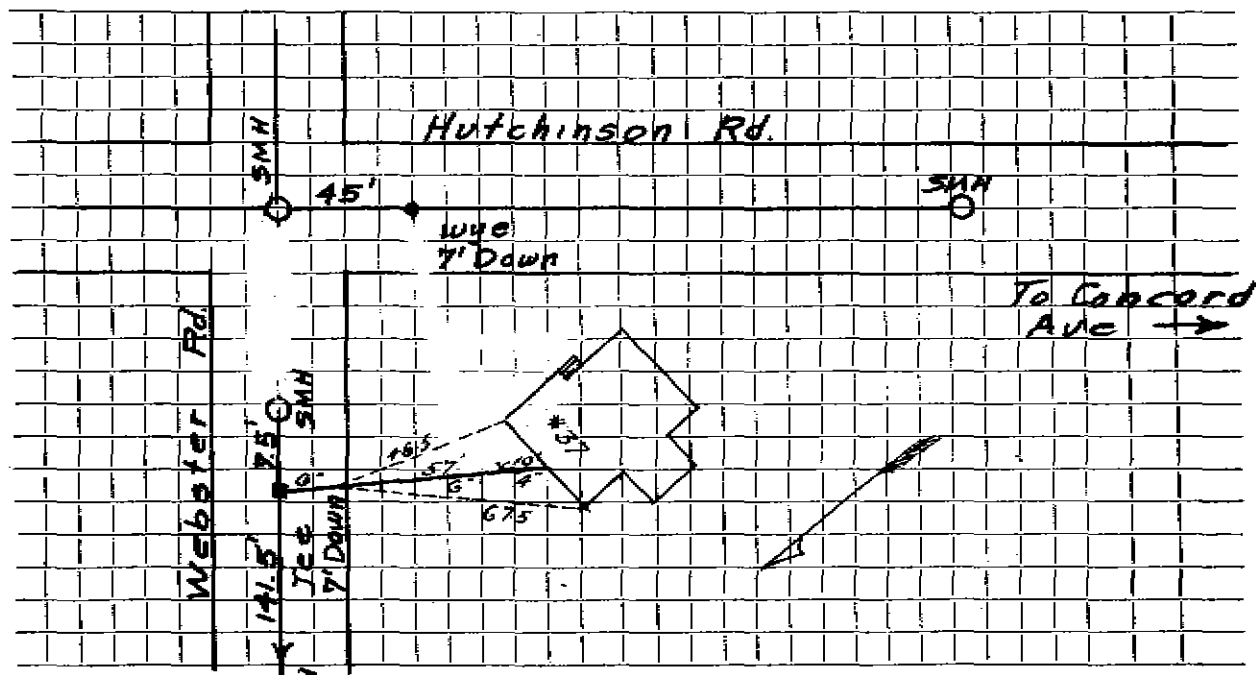

Connection made in ..... Street. Work completed .....

Remarks: .....  
.....  
.....