


DATE 3/2/22

TOWN OF LEXINGTON — BOARD OF PUBLIC WORKS
SEWER DIVISION

Sketch of Service Here

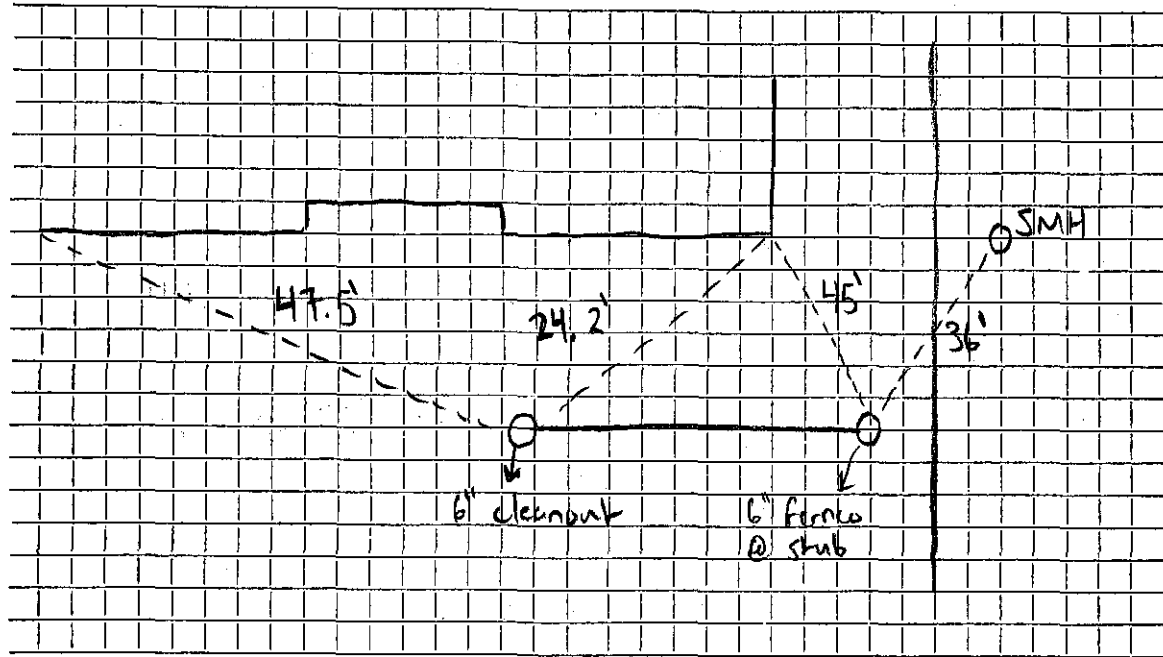

Connection made in Street. Work completed

Remarks: ... INSTALLED ... By ... LYNCH DEVELOPMENT