

Name Arthur Hurley Jr.

Service No. 170

Address # 4 WEBSTER ROAD

Location

Kind of Pipe

Size

Size of Main

~~Repair~~ ~~Renewal~~ — New Service

WC# 7683

Location

Comm 1-14-63


Date	Material	Amount	Total	Date	Amount	
10-31-62	Labor	105.40		10-23-62	Deposit	350.00
11-2-62	"	27.56		1-14-63	Refund	13.71
11-8-62	"	27.56	160.52			336.29
	10% O.H.	16.05	176.57			
97'	6" Transite pipe @.82		79.56			
1	22 $\frac{1}{2}$ <sup>o</sup> Transite Bend		4.09			
1	90 <sup>o</sup> Transite Elbow		4.09			
4	hrs. Town Shovel @6.50		26.00			
3	hrs. Trucking @3.00		<del>9.00</del> 15.00			
1	hr. Loader @5.00		5.00			
12 x 3	Patch		12.00			
	Spring Loam & Seed		20.00			
			<del>312.29</del>			
			336.29			

DATE \_\_\_\_\_

TOWN OF LEXINGTON — BOARD OF PUBLIC WORKS

SEWER DIVISION

Sketch of Service Here

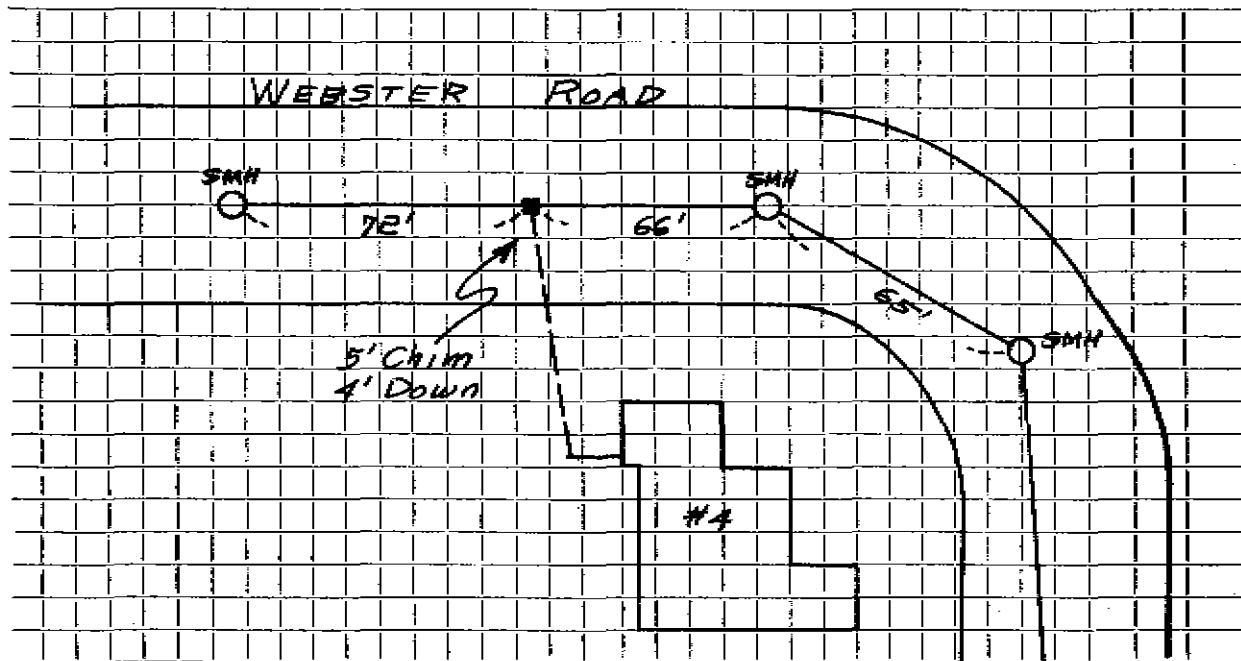

Connection made in ..... Street. Work completed .....

Remarks: .....  
.....  
.....