

Name Angelo Iannazzi

Service No. 10

Address # 41 WEBSTER RD.

Location

Kind of Pipe

Size

Size of Main

~~Repair~~ New Service ~~Installation~~ Transite Cesspool # 984 W.O. #6422

Location AUG 5 1968


Date	Material	Amount	Total	Date	Amount
5/68	Labor	81 19		4-2-68	Deposit 330 00
7/8/68	Labor	12 50		8-5-68	Refund 151 63
9/68	Labor	11 39			178 37
	10% O.H.	10 51	115 59		
	1 90° elbow		4 09		
	1 plug		3 80		
	1 11½" bend		4 09		
	15" transite pipe @ .88		13 20		
	2 ton hot top @ 5.80		11 60		
	3 hrs. trucking @ 3.00		9 00		
	1 hr. shovel		6 50		
	1 hr. compressor		5 00		
	½ hr. loader @ 4.00		2 00		
	½ hr. roller @ 3.00		1 50		
	trailer		2 00		
1-68	36' 6" Transite pipe	TOTAL COST	\$178 37		

DATE _____

TOWN OF LEXINGTON — BOARD OF PUBLIC WORKS

SEWER DIVISION

Sketch of Service Here

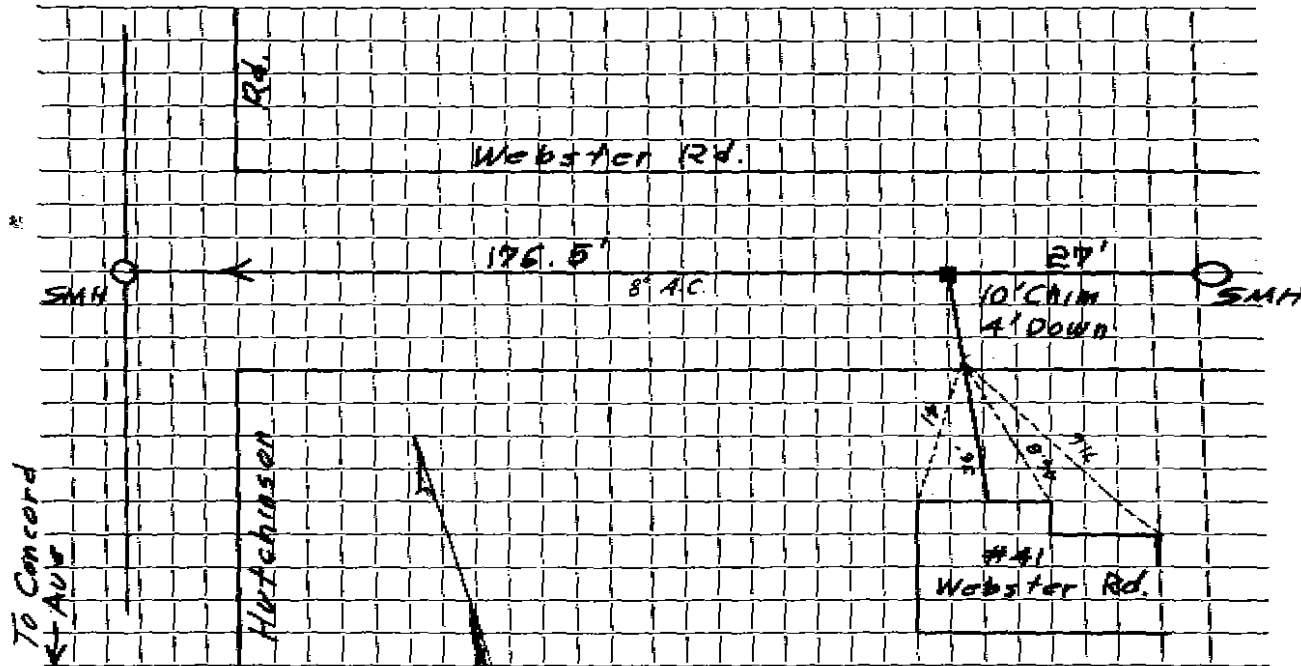

Connection made in Street. Work completed

Remarks:

.....

.....