

Name Allen Kreiger

Service No. 36

Address # 44 WEBSTER ROAD

Location

Kind of Pipe

Size

Size of Main

~~Repair~~—New Service W.O. #3311Location *Comp 7-38-75*


Date	Material	Amount	Total	Date	Amount
5-21-75	Labor	118.34		<i>5-9-75</i>	<i>Deposit</i>
	10 % O.H.	11.83	\$130.17		
20'	6" Transite Pipe	@1.27	25.40		
1	5' x 6" Nip	@1.48	7.40		
1	6" x 8" Saddle		19.53		NON-CHARGE
2½	Hrs. Trucking	@3.00	7.50	5-21-75	Labor
1	Hr. P.U.		1.50		\$47.00
1	Hr. Compressor		5.00		
3	Hrs. Backhoe	@6.50	19.50		
1	Patch 7' x 18'		84.00		
			\$300.00		

DATE _____

TOWN OF LEXINGTON — BOARD OF PUBLIC WORKS

SEWER DIVISION

Sketch of Service Here

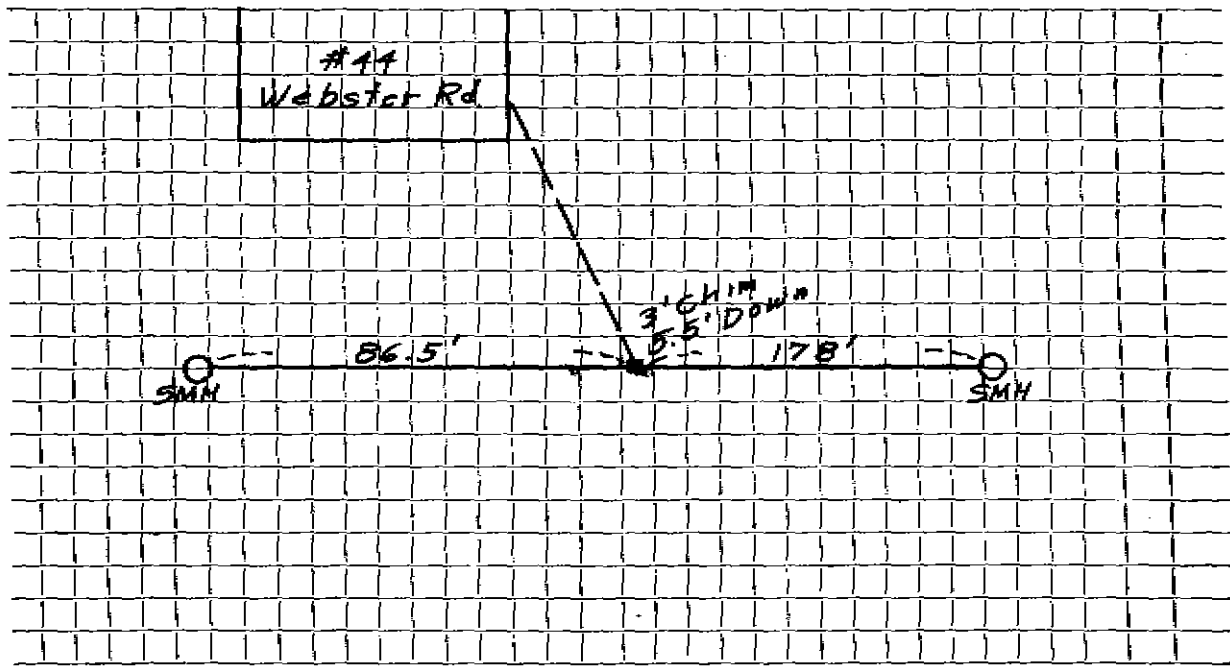

Connection made in Street. Work completed

Remarks:

.....

.....