


DATE _____

TOWN OF LEXINGTON — BOARD OF PUBLIC WORKS
SEWER DIVISION

Sketch of Service Here

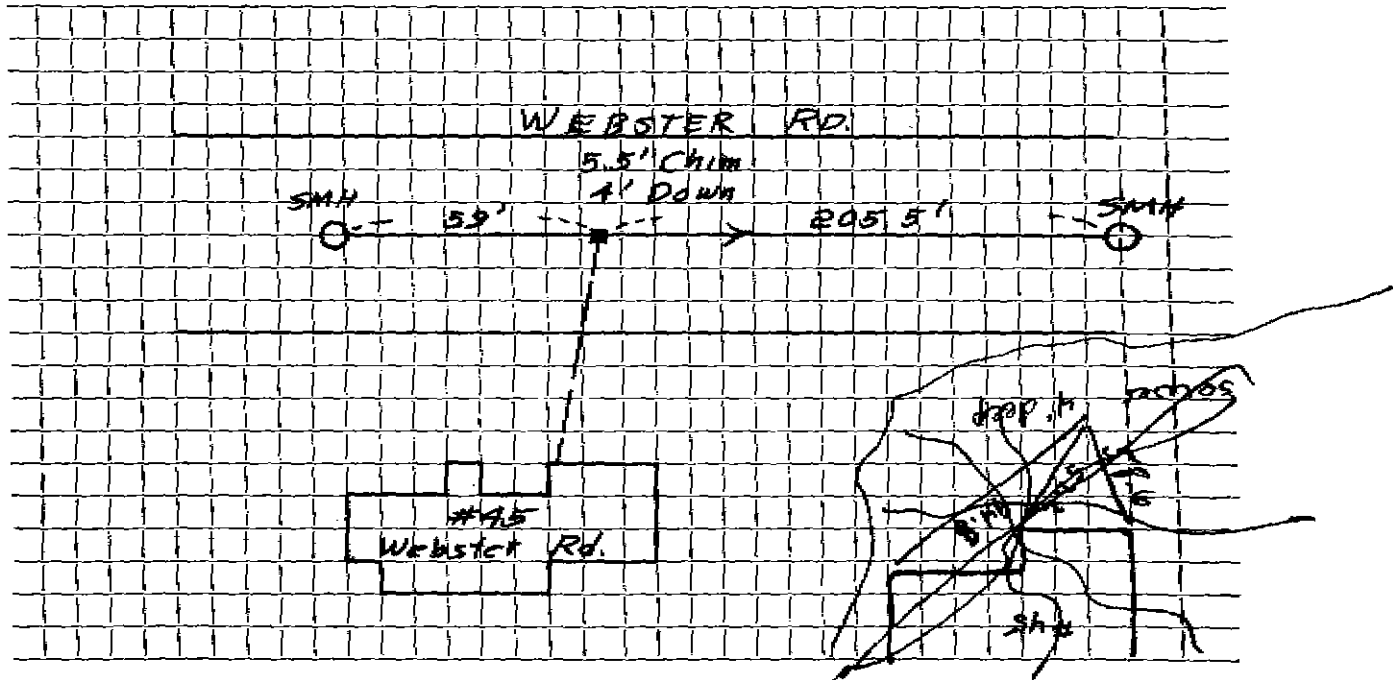

Connection made in Street. Work completed

Remarks:

.....

.....

Name **Ambrose Booth**

Service No. 164

Address **45 Webster Road**

Location

Kind of Pipe

Size

Size of Main

~~Supply~~ **New Service Lexington, Sewerage Permit# 497 W.O. #962**

Location **MAR 14 1966**

Date	Material	Amount	Total	Date	Amount
23-65	Labor	38 88		9-16-65	150 00
	10% O.H.	3 89	42 77	3-14-66	50 74
20'	6" Transite pipe @ .82		16 40		99 26
	20 x 3 Patch		20 00		
1	Elbow		4 09		
1	Hr. Town Truck		3 00		
2	Hr. Tractor @ 6.50		13 00		
			99 26		
30-65	35' 6" Transite pipe				

