

Name Lawrence Adler

Service No. 63

Address #46 WEBSTER RD.

Location

Kind of Pipe

Size

Size of Main

Repair—Renewal—New Service W.O.#4868 Valeri#666


Location MAR 18 1968

Date	Material	Amount	Total	Date	Amount
6-20-67	32.5' 6" Transite pipe			6-14-67	125 00
				4-24-68	125 00
6/14/67	Labor 60.88				
6/23/67	Labor 12.54				
" " "	Labor 20.70	94 12			
	10% O.H.	9 41	103 53		
	20' 6" transite pipe @ .88		17 60		
	1 Elbow		4 09		
	1½ ton hot top @ 5.80		8 70		
	4 hrs. trucking @ 3.00		12 00		
	2½ hrs. shovel @ 6.50		16 25		
	1 hr. compressor @ 5.00		5 00		
	1 hr. roller @ 3.00		3 00		
			170 17		
					Bill sent 45.17

DATE _____

TOWN OF LEXINGTON — BOARD OF PUBLIC WORKS
SEWER DIVISION

Sketch of Service Here

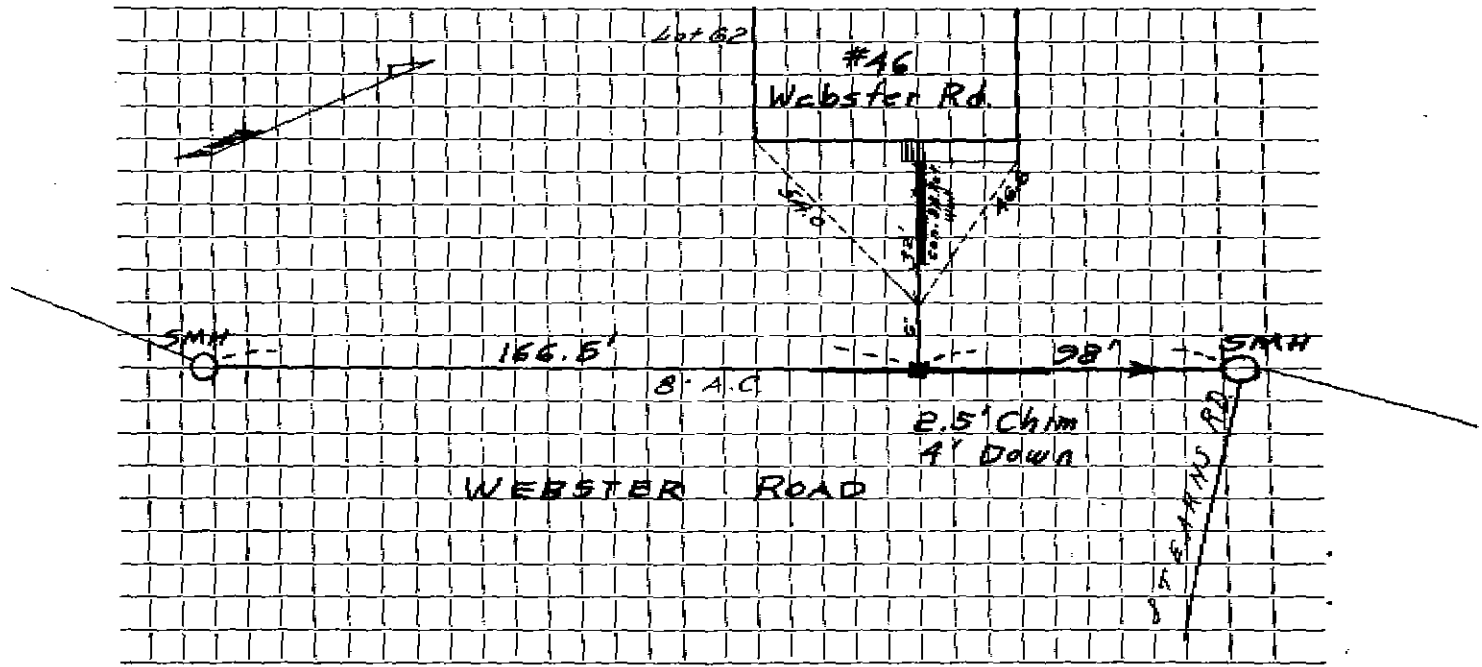

Connection made in Street. Work completed

Remarks:
.....
.....