

Name **Anthony Manetas**

Service No. 128

Address **# 47 WEBSTER ROAD**

Location

Kind of Pipe

Size

Size of Main

~~XXXXXXXXXX~~ New Service

WO # 2533

Location Comm 10-29-62


Date	Material	Amount	Total	Date	Amount	
8-20-62	Labor	92.50		8-13-62	Deposit	250.00
	10% O.H.	9.25	101.75	10-29-62	Refund	43.76
56'	6" Transite pipe @.82		45.92			206.24
1	11 1/2" Transite Bend		4.09			
1	90° Transite Elbow		2.35			
5	3/4 ton Stone @1.50		8.63			
3	hrs. Town Shovel @1.83 ^{6.50}		19.50			
2	hrs. Trucking @3.00		6.00			
1	hrs. Loader @3.00		3.00			
3	x 3 Sidewalk Patch		3.00			
12	x 3 Patch		12.00			
			206.24			

DATE _____

TOWN OF LEXINGTON — BOARD OF PUBLIC WORKS

SEWER DIVISION

Sketch of Service Here

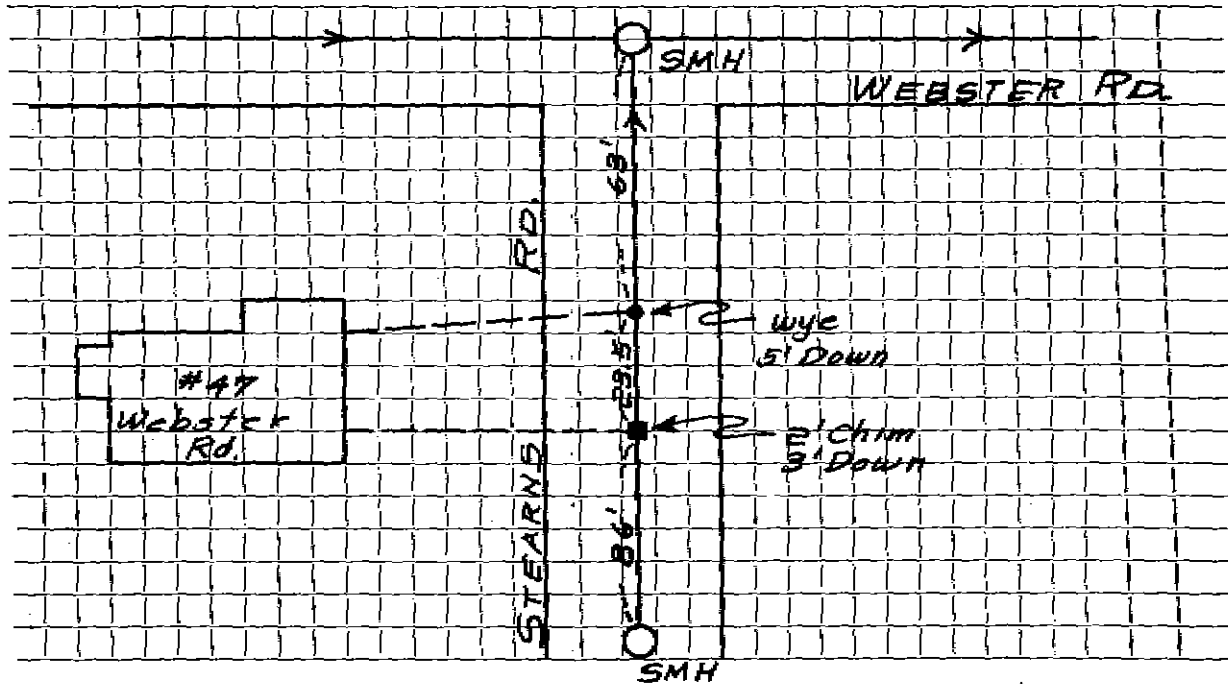

Connection made in Street. Work completed

Remarks:

.....

.....