

Name Leonard Dubin

Service No. 123

Address #48 WEBSTER RD.

Location

Kind of Pipe

Size

Size of Main

~~REPORT REQUIRED~~ — New Service

W O H 2511

Location

Comm 10-29-62


Date	Material	Amount	Total	Date	Amount
3-17-62	Labor	108.74		7-11-62	Deposit 300.00
3-18-62	"	37.95	146.69	10-25-62	Refund 47.27
	10% O.H.	14.67	161.36		252.73
	54' 6" Transite pipe @82		44.28		
	7 3/4 Ton Bank Gravel @85		6.59		
	3 Hrs. Town Shovel @6.50		19.50		
	3 Hrs. Trucking @3.00		9.00		
	1 Hr. Loader @3.00		3.00		
	9X3 Patch		9.00		
			252.73		

DATE _____

TOWN OF LEXINGTON — BOARD OF PUBLIC WORKS

SEWER DIVISION

Sketch of Service Here

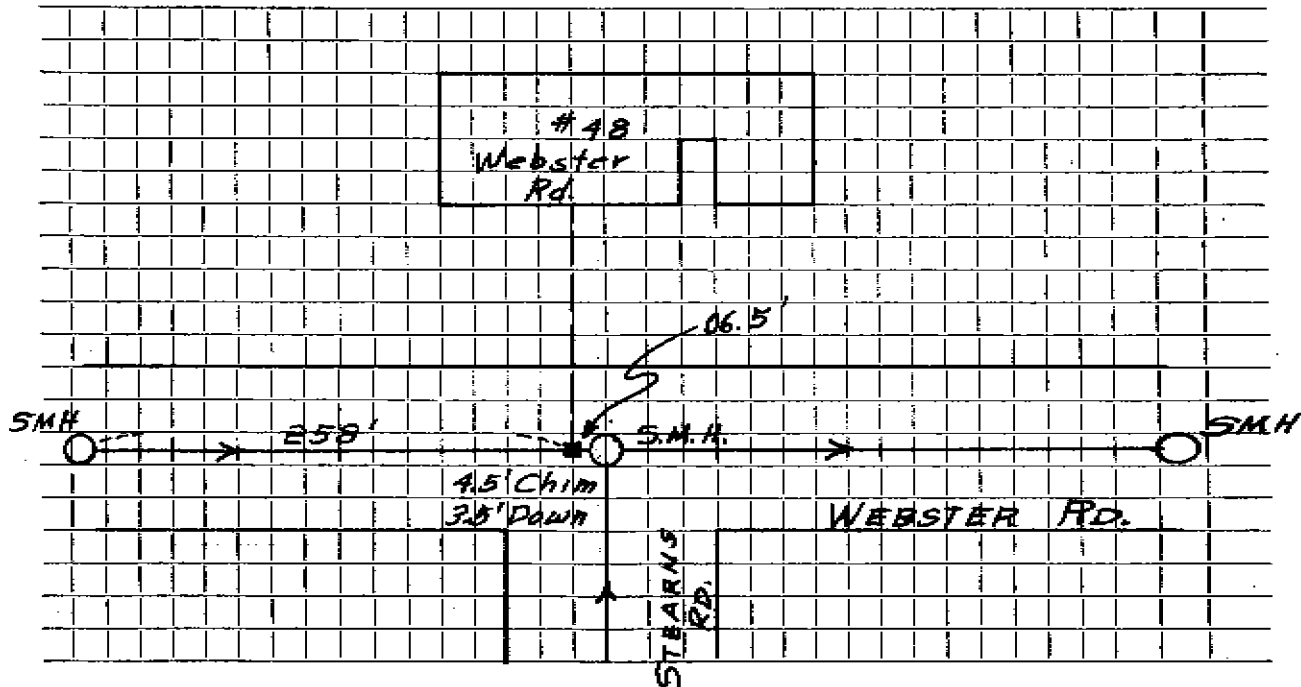

Connection made in Street. Work completed

Remarks:
.....
.....