


DATE _____

TOWN OF LEXINGTON — BOARD OF PUBLIC WORKS

SEWER DIVISION

Sketch of Service Here

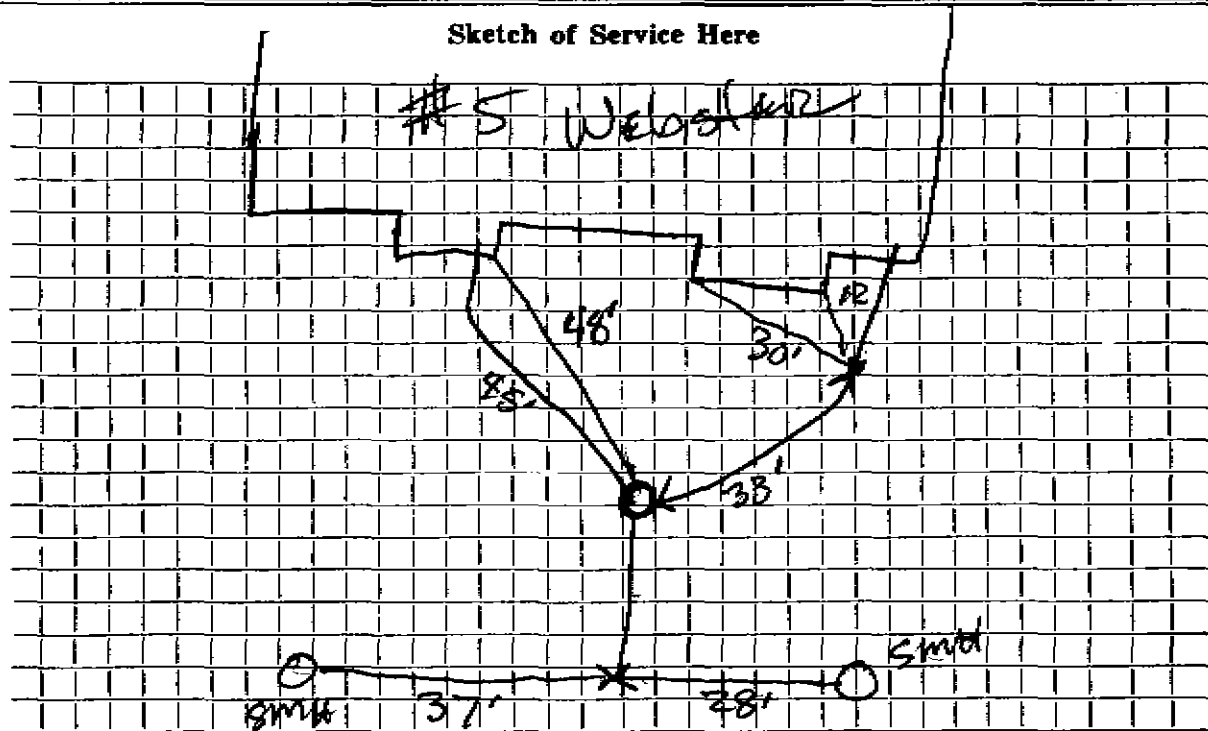

Connection made in _____ Street. Work completed _____

Remarks: *Service connected to main
3'5" chime 4" Down*