

Name **Thomas DiSilva**

Service No.

Address **7 Webster Road**

Lot **#76 165 Land Court**

Location

Kind of Pipe

Size

Size of Main

Repair—Renewal—New Service **Ferrari #A421**


Location

Date		Material	Amount		Total		Date		Amount	
9-15-66	44'	4" Cast Iron pipe								

DATE \_\_\_\_\_

# TOWN OF LEXINGTON — BOARD OF PUBLIC WORKS SEWER DIVISION

Sketch of Service Here

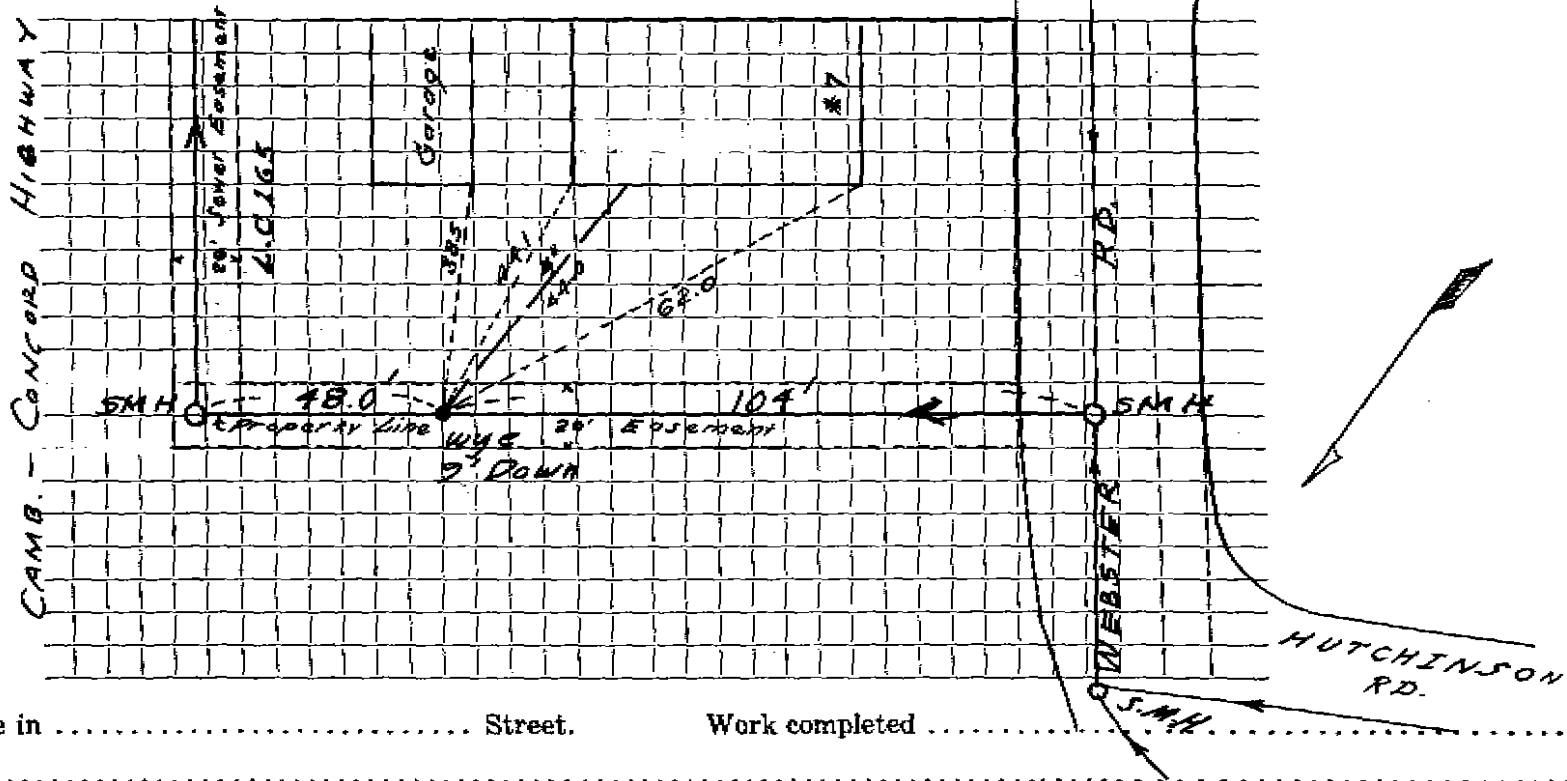

Connection made in ..... Street. Work completed .....

Remarks: .....  
.....  
.....