

Name Frederick Jackson

Service No.

1

Address 9 Webster Road

Location

Kind of Pipe

Size

Size of Main

~~REPAIR SERVICE~~ - New Service

WO #7019

Location

Comm 5-28-62


Date	Material	Amount	Total	Date	Amount
4-2-62	Labor 95.11			1-3-62	Deposit 250 00
4-3-62	" 72.88	167.99		10-5-62	on 9c 34 15
	10% O.H.	16.80	184.79	3-6-64	Paid 35 00
	49' 6" Transite pipe @.78		38.22	4-6-64	Paid 20 00
	12 1/2 ton Fill @.70		8.75	6-1-64	Paid 55 00
	55 3/4 ton Bank Gravel @.85		47.39		394 15
	11 1/2 ton 3/4" Stone @1.50		17.25		
	1 6 x 12 Iron Saddle		6.25		
	7 hrs. Town Shovel @6.50		45.50		
	6 hrs. Trucking @3.00		18.00		
	1 hr. Trailer @3.00		3.00		
	5 hrs. Pump @1.00		5.00		
	20 x 3 Patch		20.00		
			394.15		

DATE _____

TOWN OF LEXINGTON — BOARD OF PUBLIC WORKS

SEWER DIVISION

Sketch of Service Here

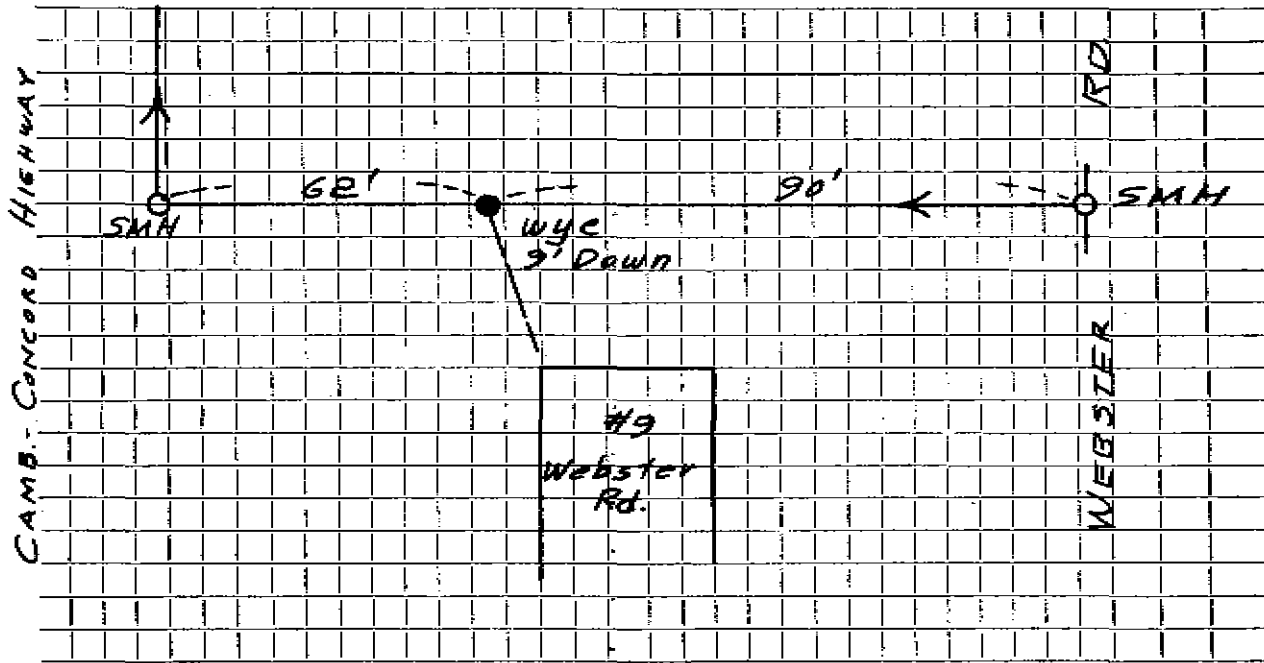

Connection made in Street. Work completed

Remarks:

.....

.....