

Name Helen A. Bateson

Service No. 129

Address 10 Welch Road

10 Welch Road

Location

Kind of Pipe

Size 6"

Size of Main 8"

~~REPAIR~~ Renewal ~~REPAIR SERVICE~~ W.O.#814

Location MAR 14 1965

Date	Material	Amount	Total	Date	Amount
2/65	Labor	116.97		8-11-65	110.00
3/65	Labor	42.49	158.46	9-21-66	156.95
	10% O.H.	15.85	174.31		106.76
57'	6" Transite pipe @ .82		46.74		
4	Yards Loan @ 3.00		12.00		
2	Lbs Grass seed @ .95		1.90		
4	Hrs Tractor @ 6.50		26.00		
2	Hrs Town Truck @ 3.00		6.00		
			266.95		

10 years

$\frac{266.95}{25} \times 10 = 106.78 = \322 Refund


Bill sent 156.95

DATE _____

TOWN OF LEXINGTON — BOARD OF PUBLIC WORKS

SEWER DIVISION

Sketch of Service Here

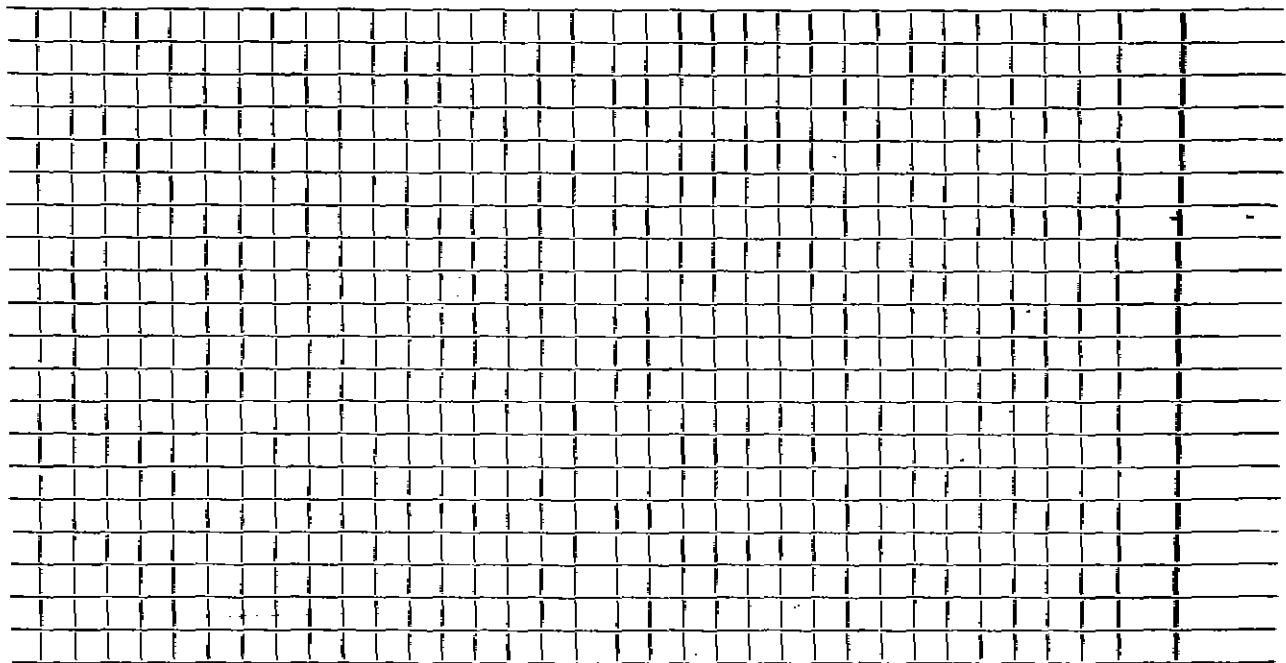

Connection made in Street. Work completed

Remarks:
.....
.....