

Name Arthur Oxford

Service No. 81

Address 15 Welch Road

15 Welch Road

Location

Kind of Pipe

Size 6"

Size of Main 8"

\*\*\*Repair—Renewal—New Service W.O. #7364

Location JAN 27 1969


Date	Material	Amount	Total	Date	Amount
9/16/68	Labor	73 49		9-16-68	185 08
9/17/68	"	40 59	114 08	2-7-69	25 57
	10% O.H.		11 41		210 57
40'	6" Transitepipe .88		35 20	10/1/68	Labor 76 90
1/2	Bag Cement 1.55		78	18'	6" Transite .88 15 84
2	Yds. Loam 3.50		7 00	1/2	Bag cement 1.55 78
1	Lb/ Seed		1 10	3	Ton hot top 5.80 19 50
5	Hrs. Trucking 3.00		15 00	3 1/2	Hrs. Trucking 3.00 10 50
4	" Shovel 6.50		26 00	1/2	" " 1.50 75
			210 57	2 1/2	Hrs. Shovel 6.50 16 25
				1/2	" Compressor 5.00 2 50
				1/2	" Roller 3.00 1 50
					Trailer 2 00
					146 52
					Bill sent 25.57

DATE \_\_\_\_\_

**TOWN OF LEXINGTON — BOARD OF PUBLIC WORKS**

**SEWER DIVISION**

Sketch of Service Here

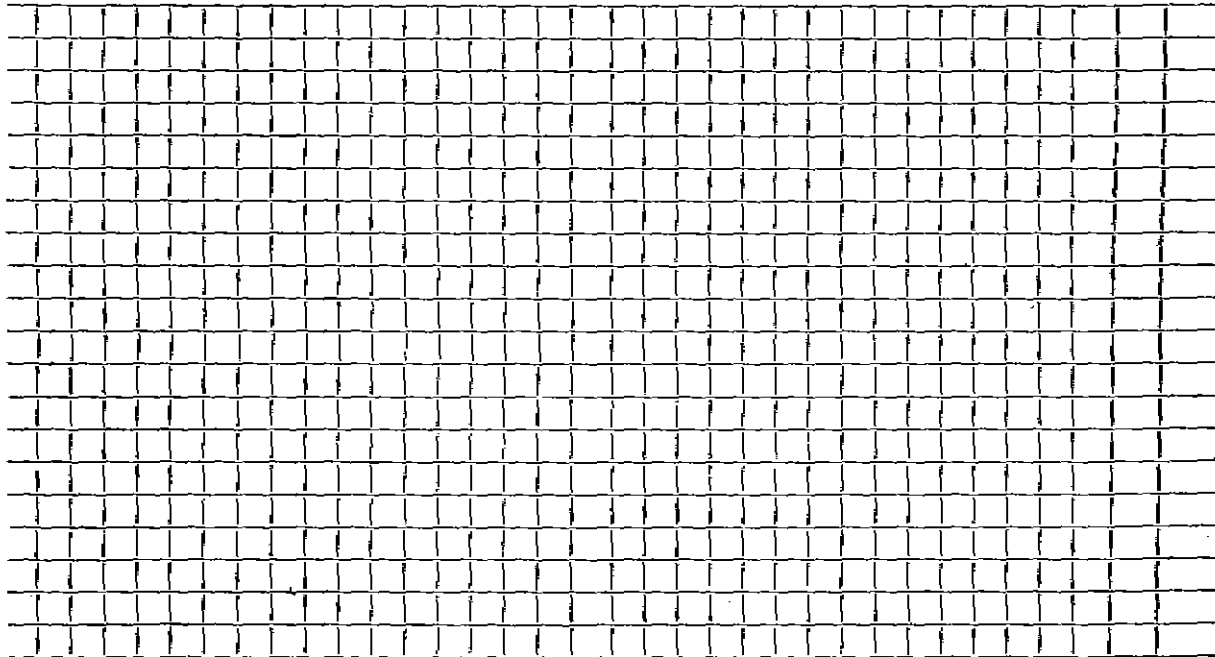

Connection made in ..... Street. Work completed .....

Remarks: .....  
.....  
.....