

Name John Alexander

Service No. 132

Address # 19 WELCH RD.

19 Welch Road

Location

Kind of Pipe

Size 6"

Size of Main 8"

~~REPAIR-RENEWAL~~ ~~MANHOLES~~

Location

Chas. P. 21-64


Date	Material	Amount	Total	Date	Amount
-3-64	Labor	95.57			
	10% O.H.	9.56	105.13		
	34' 6" Transite pipe @.82		27.88		
	1 6" 90° Transite Elbow		4.90		
	1 6" Transite Y		4.09		
	1 22½° Transite Bend		4.09		
	1 11¼° Transite Bend		4.09		
	1 6" Transite End Cap		1.93		
	2 hrs. Town Shovel @6.50		13.00		
	2 hrs. Town Truck @3.00		6.00		
	3 yds. Loam @3.00		9.00		
	12 x 3 Patch		12.00		
			192.11		
	192.11 x 7 = 53.76				
	25				
				7-30-64	
					508.866

Remarks:

Connection made in

Street

Work completed

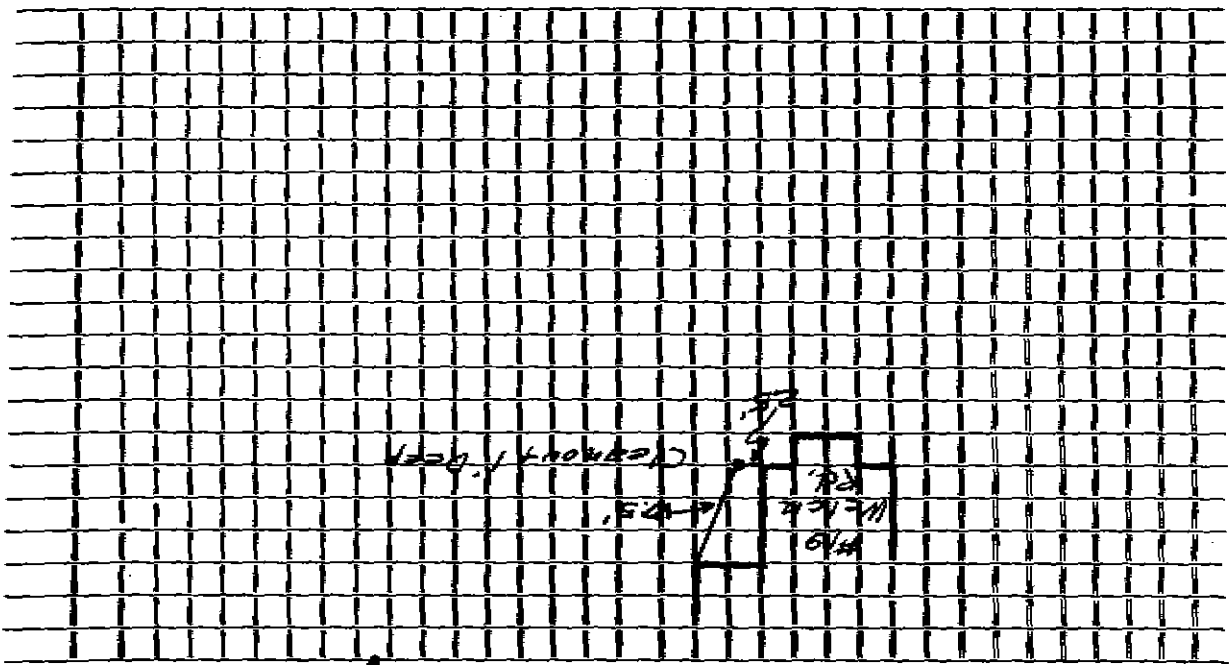

Sketch of Service Here

19

SEWER DIVISION

TOWN OF LEXINGTON — BOARD OF PUBLIC WORKS

DATE