




DATE 3-19-96

TOWN OF LEXINGTON — BOARD OF PUBLIC WORKS  
SEWER DIVISION

Sketch of Service Here 21

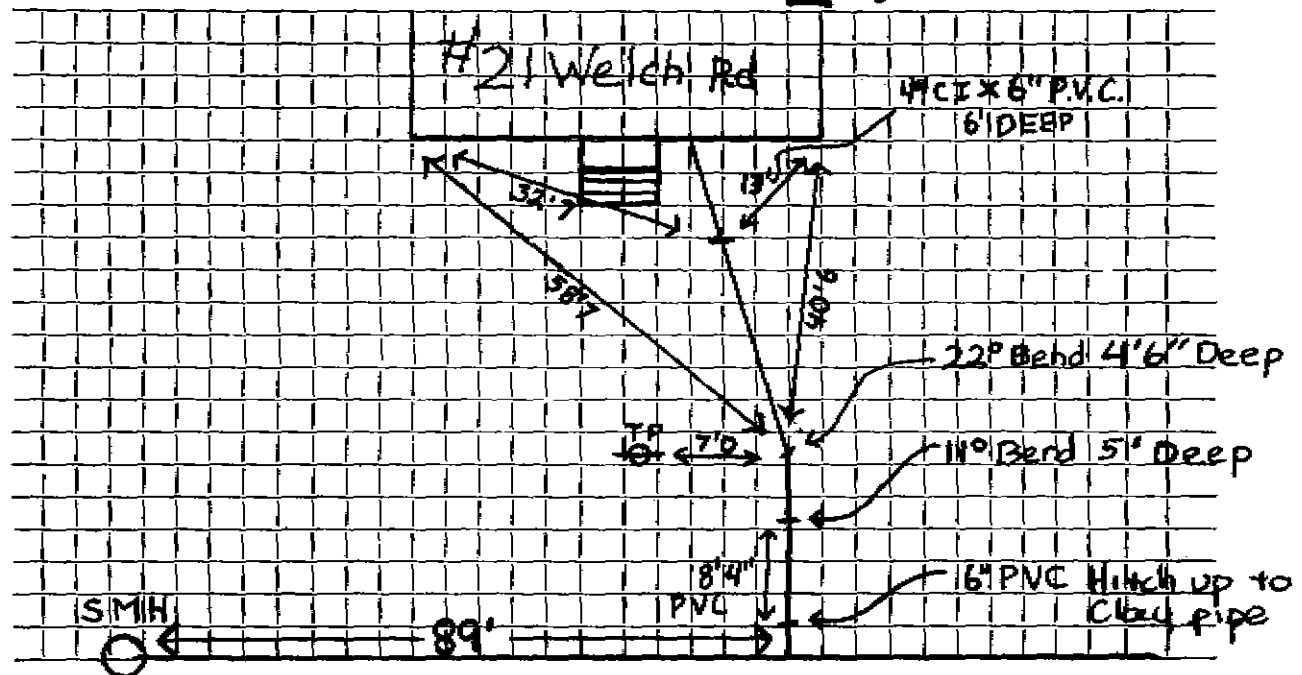

Connection made in Welch Rd Street. Work completed 3-18-96

Remarks: Renewed town side in "96" has 3' stub of clay pipe coming off of main in street.