


DATE 9/10/80

TOWN OF LEXINGTON — BOARD OF PUBLIC WORKS
SEWER DIVISION

Sketch of Service Here //

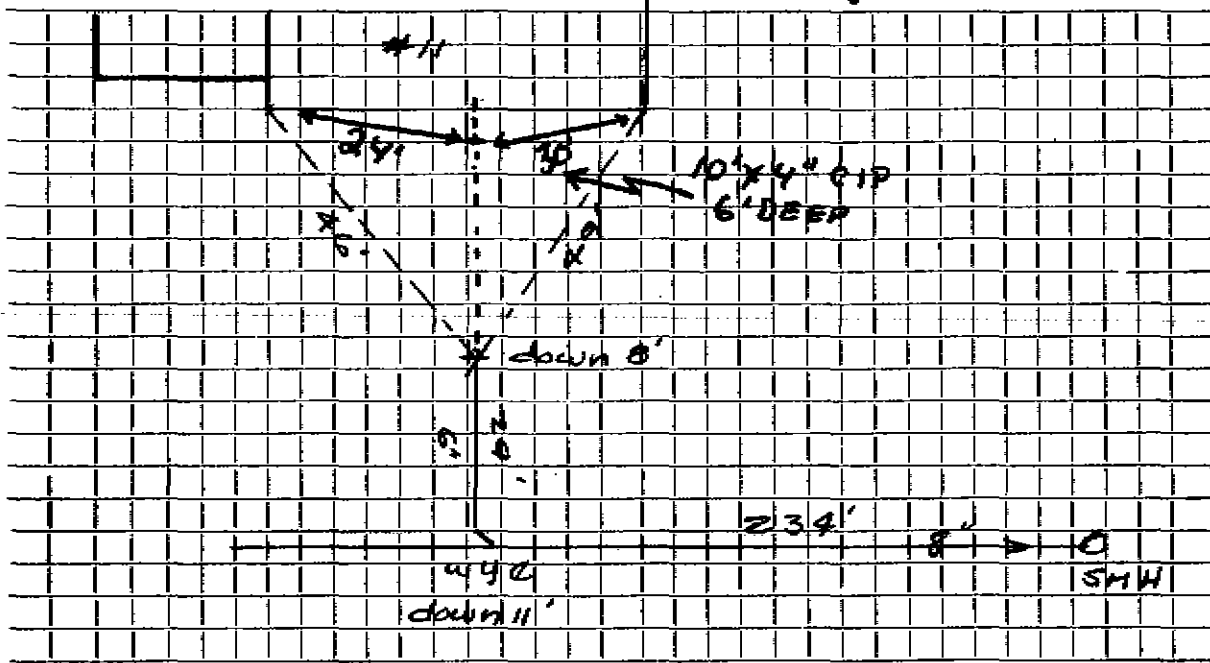

Connection made in WELLINGTON LANE Street. Work completed

Remarks: