


DATE 9/10/80

TOWN OF LEXINGTON — BOARD OF PUBLIC WORKS

SEWER DIVISION

Sketch of Service Here **15**

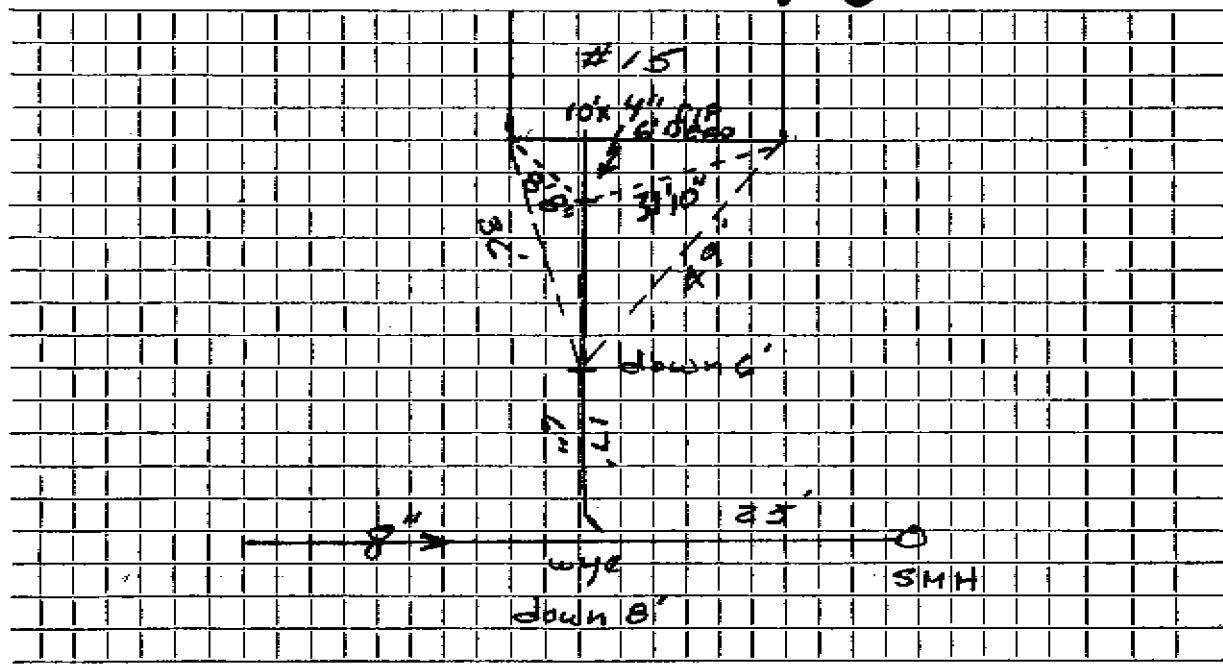

Connection made in WELLINGTON LANE Street. Work completed

Remarks: