




DATE 9/10/80

TOWN OF LEXINGTON — BOARD OF PUBLIC WORKS

SEWER DIVISION

Sketch of Service Here

16

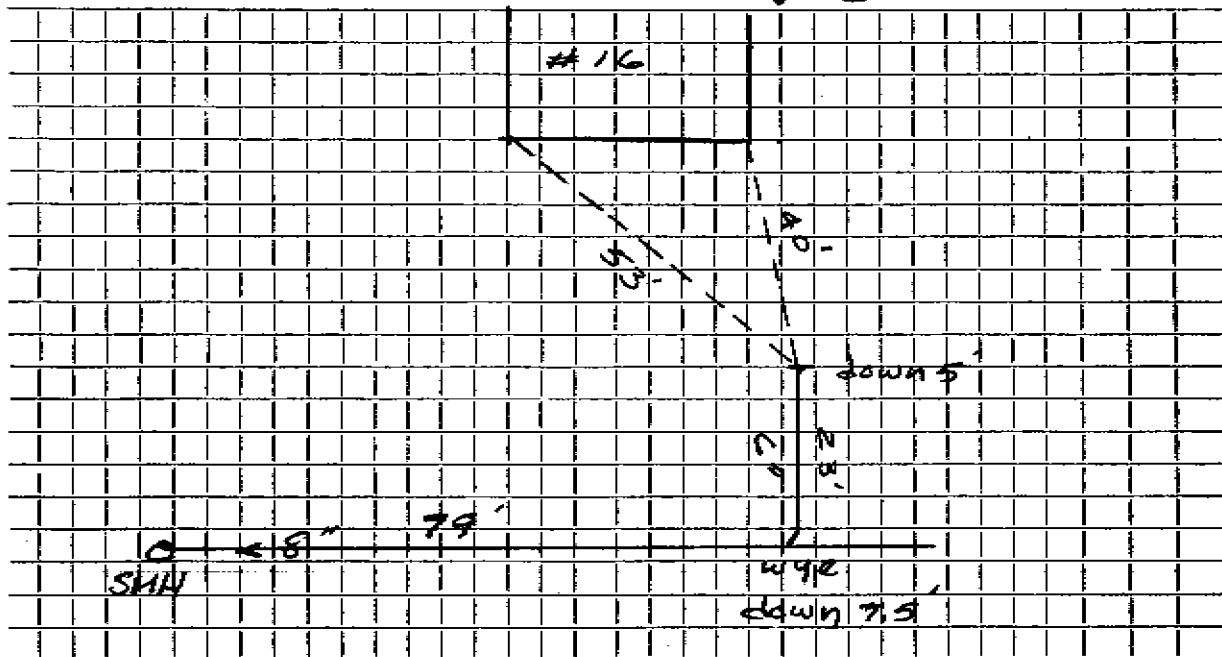

Connection made in WELLINGTON LANE Street.

Work completed .....

Remarks: .....  
.....  
.....