


DATE JULY 1 1998

TOWN OF LEXINGTON — BOARD OF PUBLIC WORKS

SEWER DIVISION

Sketch of Service Here

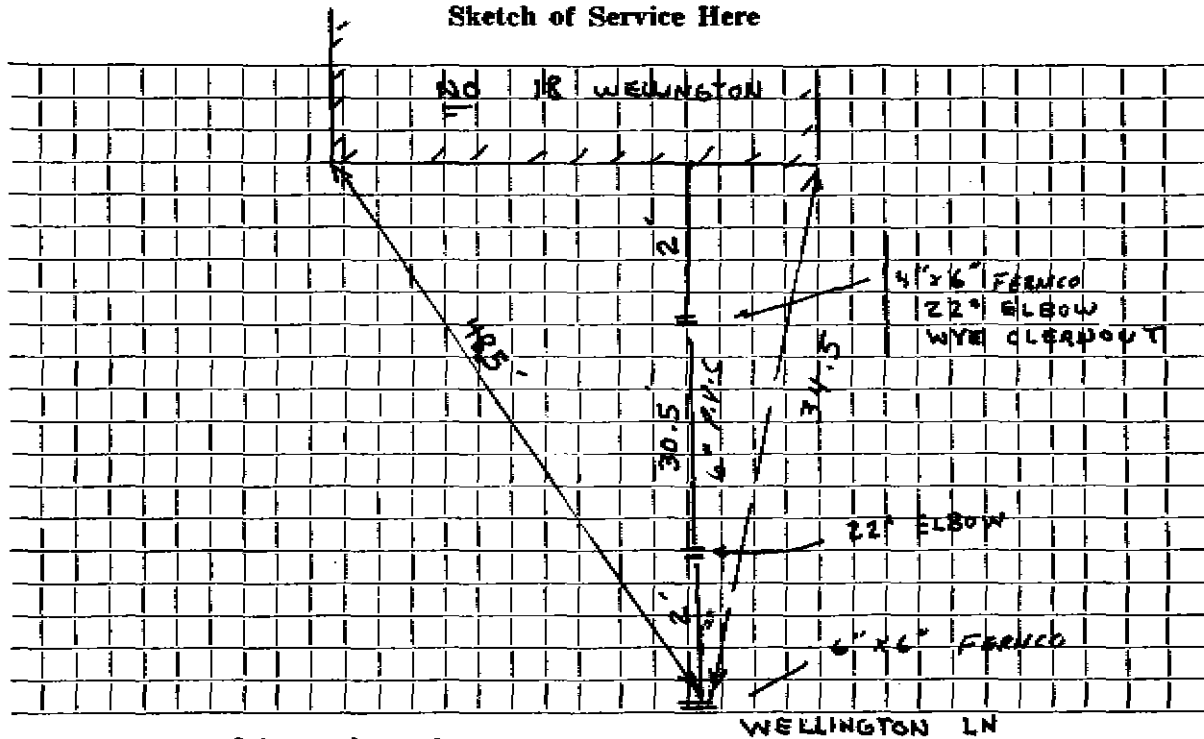

Connection made in WELLINGTON LANE Street.

Work completed DAVID SANTO G.C.


Remarks:

DATE 9/10/80

TOWN OF LEXINGTON — BOARD OF PUBLIC WORKS

SEWER DIVISION

Sketch of Service Here **18**

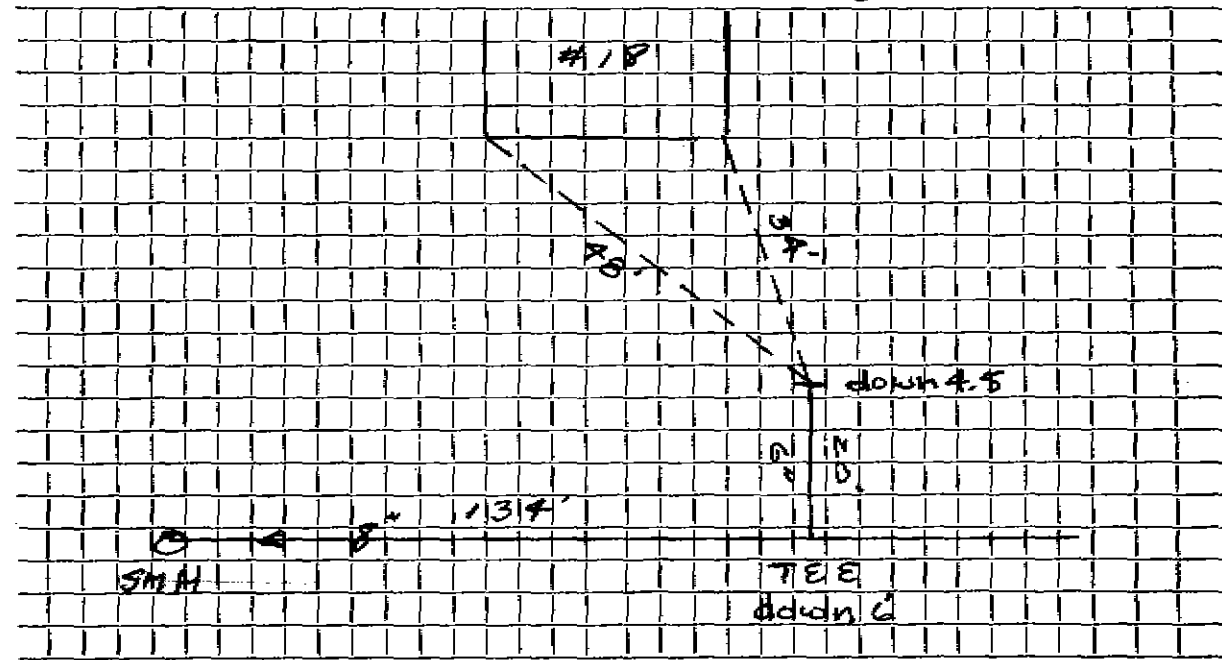

Connection made in WELLINGTON LANE Street. Work completed

Remarks:
.....
.....