


DATE 9/10/80

TOWN OF LEXINGTON — BOARD OF PUBLIC WORKS

SEWER DIVISION

Sketch of Service Here

51

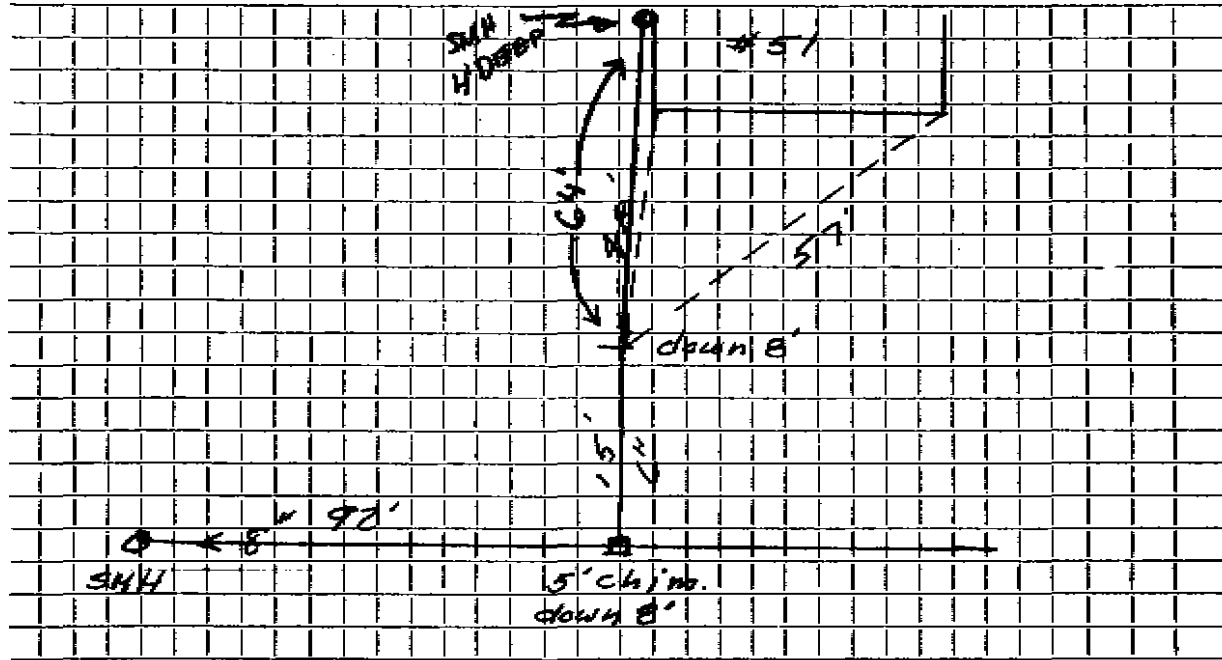

Connection made in WELLINGTON LANE Street. Work completed

Remarks: Brick Manhole 4' Deep