


DATE _____

TOWN OF LEXINGTON — BOARD OF PUBLIC WORKS

SEWER DIVISION

Sketch of Service Here

7

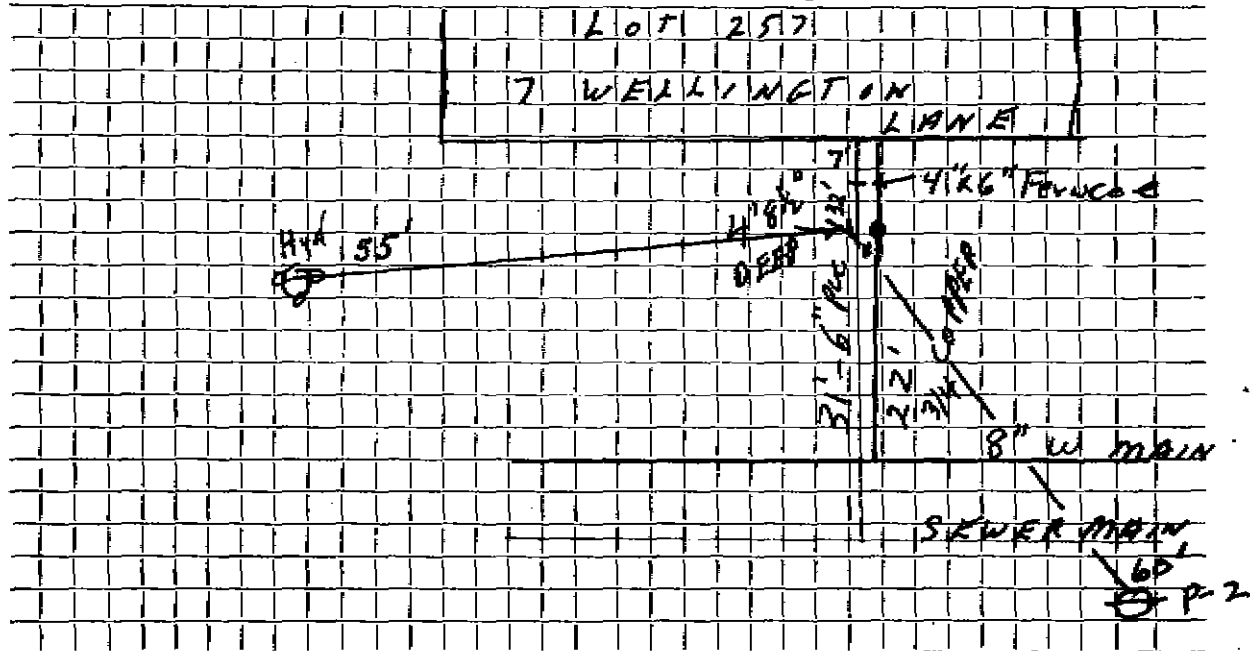

Connection made in Street. Work completed

Remarks: AT CURB SEWER & WATER 2' APART