


DATE 9/2/59

TOWN OF LEXINGTON — BOARD OF PUBLIC WORKS

SEWER DIVISION

Sketch of Service Here **12**

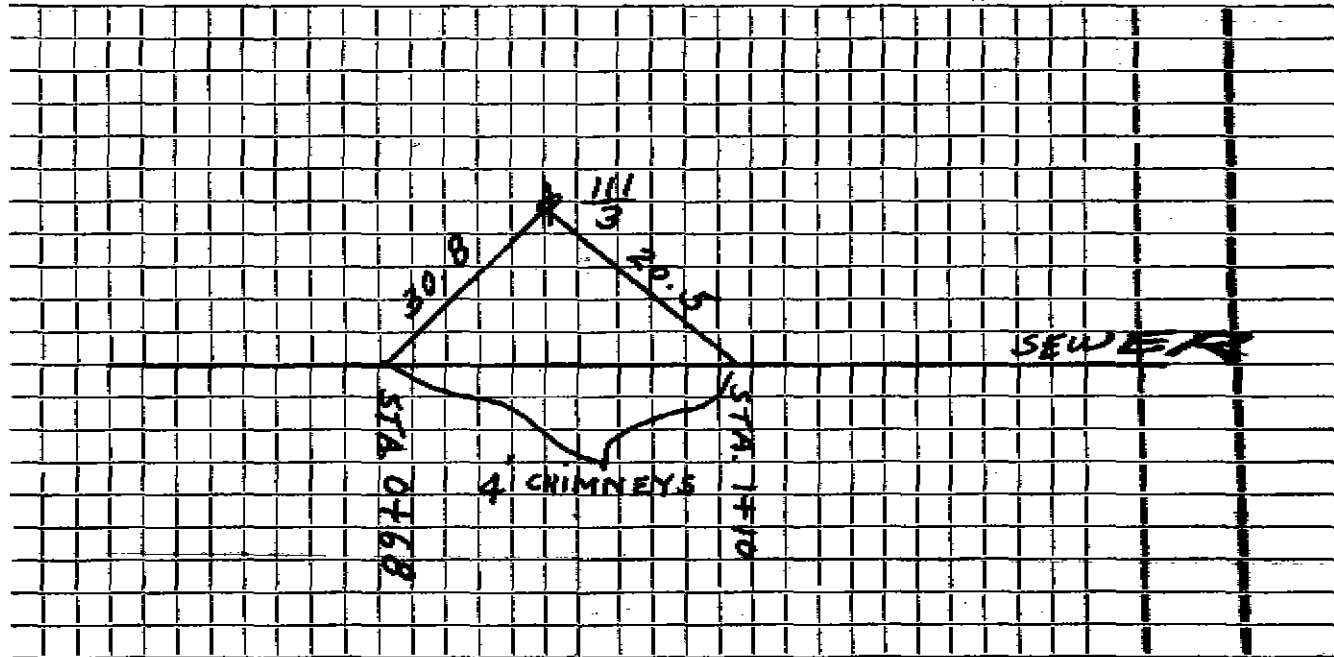

Connection made in WESTMINSTER Street. Work completed

Remarks: