

Name Stephen Aghazarian

Service No. 77

Address 4 Westminister Avenue

4 Westminister Avenue

Location

Kind of Pipe

Size 6"

Size of Main 8"

~~Standard Service~~ New Service W.O. #8044

Location Comm 10-28-63


Date	Material	Amount	Total	Date	Amount
3-63	Labor	110.14		6-24-63	250.00
	10% O.H.	11.01	121.15	10-28-63	17.28
	54' 6" Transite pipe @.82		44.28		232.72
	1 90° Transite Elbow		4.09		
	2 11 1/4° Transite Elbows @2.35		4.70		
	27 x 3 Patch		27.00		
	3 hrs Town Shovel @6.50		19.50		
	3 hrs. Trucking @3.00		9.00		
	1 hr. Trailer @3.00		3.00		
			232.72		

DATE _____

TOWN OF LEXINGTON — BOARD OF PUBLIC WORKS
SEWER DIVISION

Sketch of Service Here

4

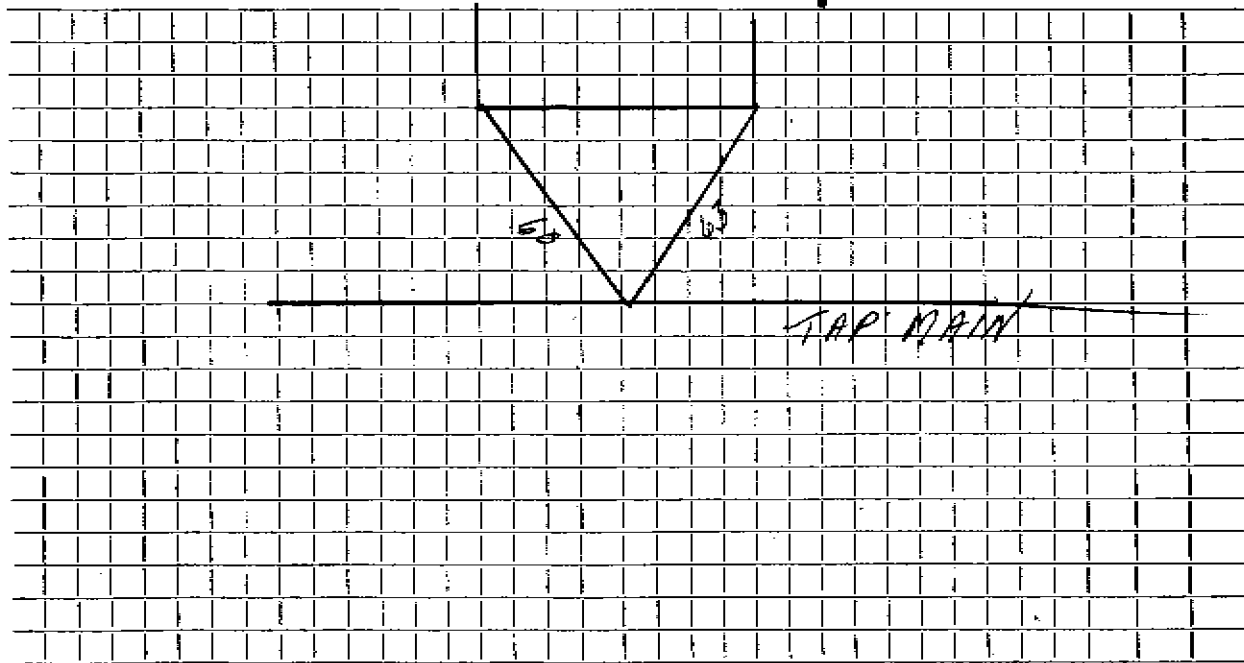

Connection made in Street. Work completed

Remarks:
.....
.....