


TOWN OF LEXINGTON — BOARD OF PUBLIC WORKS

SEWER DIVISION

DATE _____

Sketch of Service Here

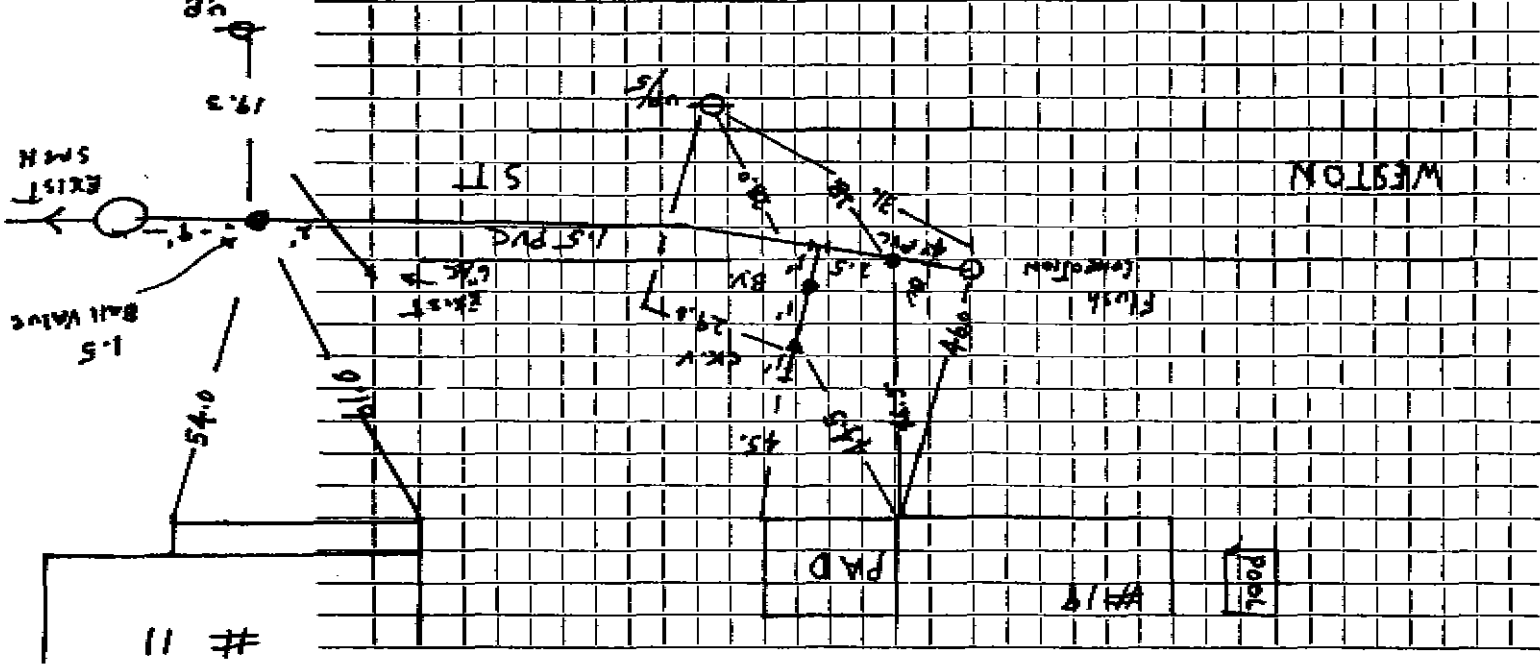

Connection made in WESTON ST Street.

Work completed 2/30/01 / 8/28/01

Remarks: _____