

Name Frank Bertulla

Service No. 79

Address 3 Weston Street

3 Weston Street

Location

Kind of Pipe

Size 6"

Size of Main 8"

~~REPAIR WORK~~—New Service

Location Conn 8-1-60

Date	Material	Amount	Total	Date	Amount
-7-60	Labor	69.80		6-24-60	Deposit 200.00
-8-60	"	90.87		8-1-60	Paid by WPA 28.13
		160.67			
	10% O.H.	16.07	176.74		
	45' 6" Transite pipe @ .78		35.10		
	12 Sticks dynamite @ .26		3.12		
	12 Blasting caps @ .28		3.36		
	1 6" duplex adapter		1.90		
	9 hrs. town shovel @ 6.50		58.50		
	4 hrs. trucking @ 3.00		12.00		
	4 hrs. compressor @ 3.00		12.00		
	19x3 patch		19.00		
	Labor		321.72		
				Bill sent 8-1-60	93.50

TOWN OF LEXINGTON—DEPT. OF PUBLIC WORKS
SEWER DIVISION

DATE.....

NO.

The undersigned applies for the construction of a particular sewer connecting No.....
Street and hereby agrees to comply with the Rules and Regulations governing the construction and use of Particular
Sewers, as now or at any future time established by the Board of Selectmen.


Am't of estimate \$.....

Am't Paid \$.....

..... Owner

Sketch of Service Here

3

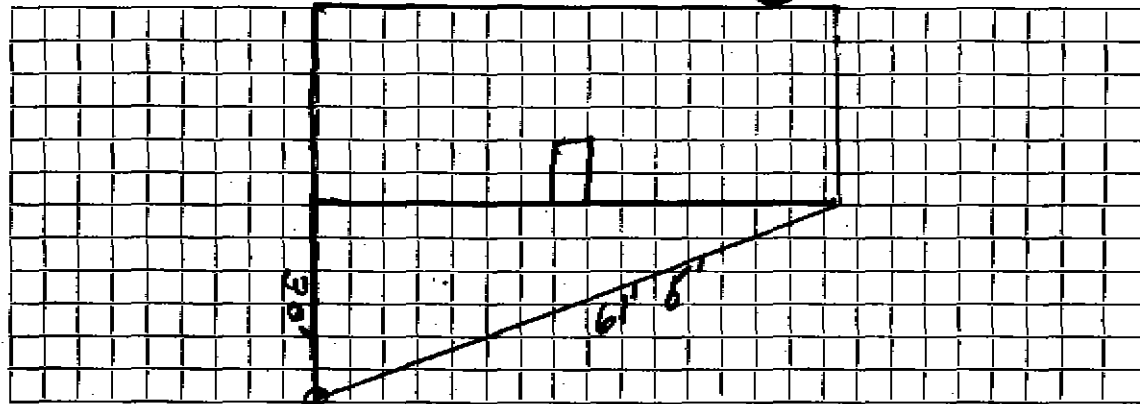

Connection made in..... Street.

Work completed..... 19..

Remarks: