

Real Estate Realty Trust
Address #1 CO Westview St.

Service No.

Location

Kind of Pipe AC **Size 6" 50'** **Size of Male 12"**

Repeat - Discount - New Service

Location


Date	Material	Amount	Total	Date	Amount
	114' of 6" MCP				
	243' of 6" MCP				

TOWN OF LEXINGTON — BOARD OF PUBLIC WORKS

SEWER DIVISION

DATE _____

Sketch of Service Here

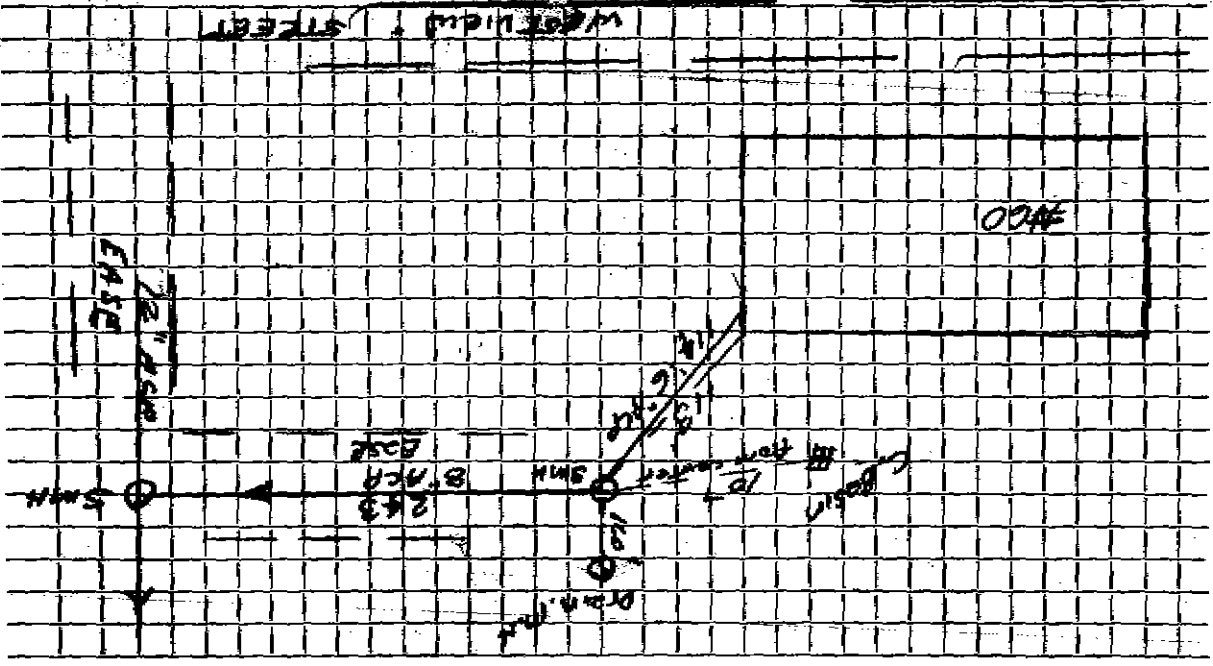

Work completed

Street

EASEMENT

Connection made in

Remarks: