




DATE \_\_\_\_\_

TOWN OF LEXINGTON — BOARD OF PUBLIC WORKS  
SEWER DIVISION

Sketch of Service Here

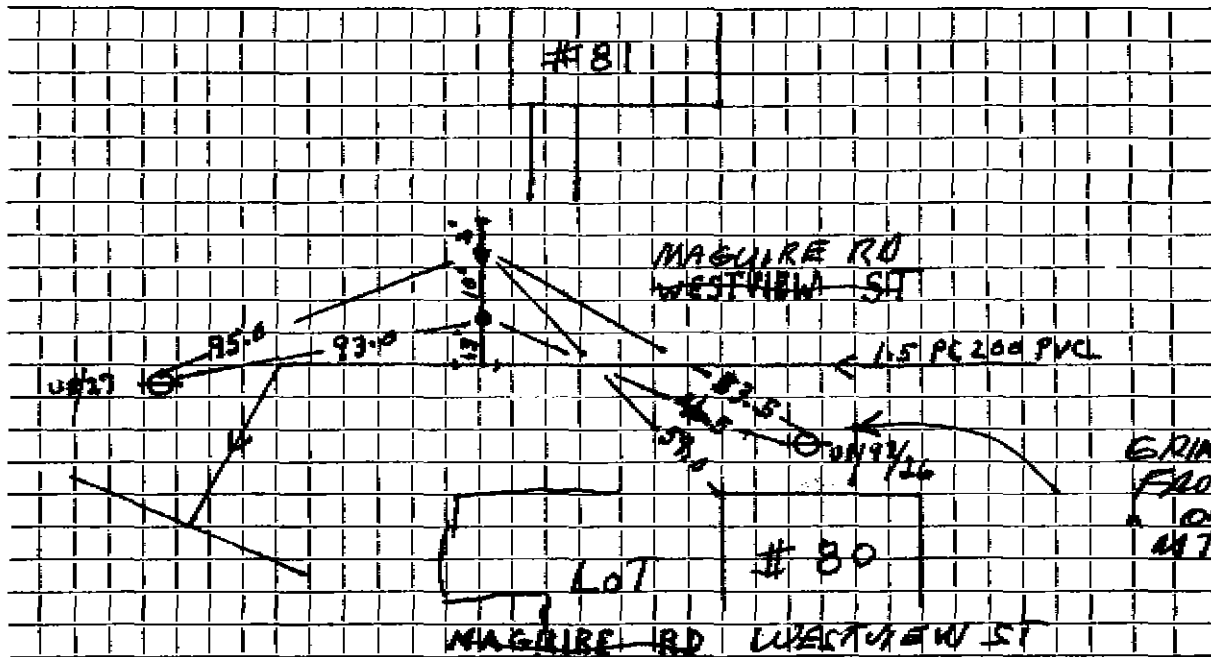

9/6/06  
Sewer BU.

GRINDER PUMPS  
FROM 2 HOUSES  
ON WESTVIEW  
ST INTO MH  
↓ ↓

Connection made in WESTVIEW ST. Street. Work completed 9/12/01

Remarks: .....