

Name

Service No.

Address 85 WESTVIEW ST

Location

Kind of Pipe PVC PC200

Size 1.5

Size of Main 1.5 PC200

Repair—Renewal—New Service


Location

Date	Material	Amount	Total	Date	Amount
9/11/01 28'	1.5 PVC				
	1.5 BALL VALVE				
	1.5 CHECK VALVE				
	1.5 TEE				
	Buff 10 Box	TOTAL STUDIES:	\$975.00		

DATE _____

TOWN OF LEXINGTON — BOARD OF PUBLIC WORKS
SEWER DIVISION

Sketch of Service Here

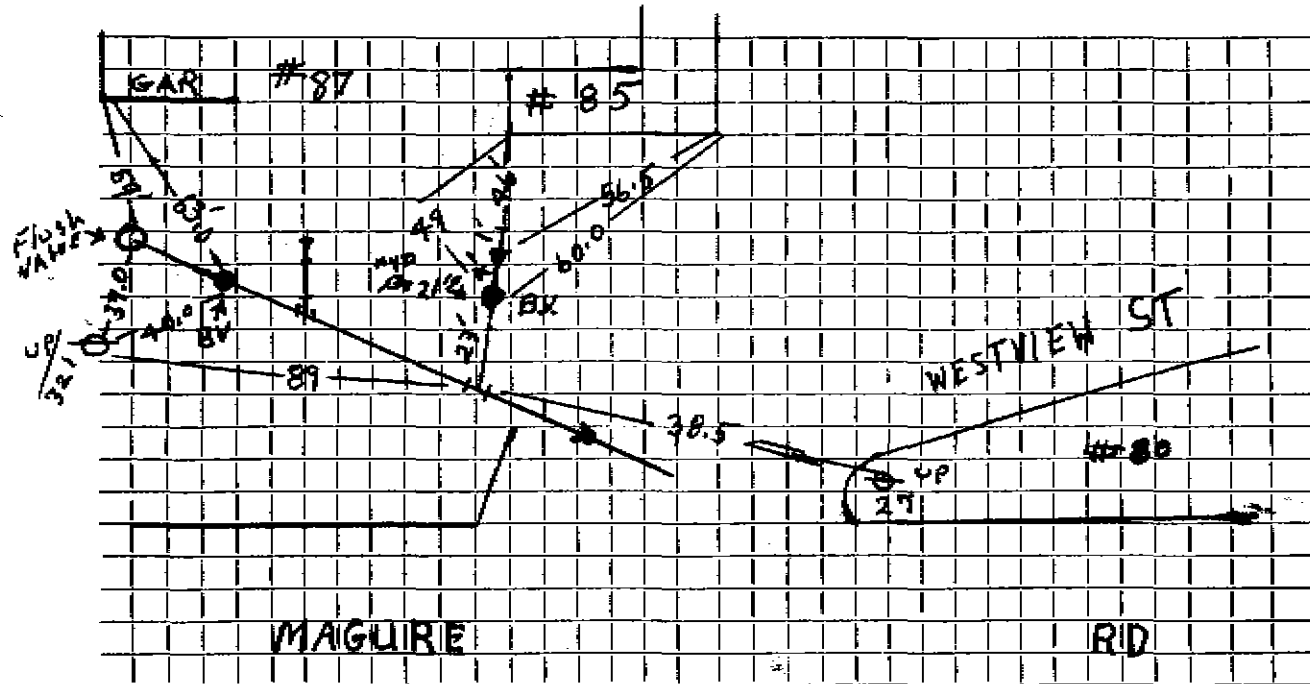

Connection made in WESTVIEW ST Street. Work completed

Remarks:

.....

.....