

Name

Contractor: JM McLaughlin

Service No.

Address

3 Westwood

Location

Kind of Pipe

SDR 35 PVC

Size

6"

Size of Main

Repair ~~Renewal~~ New Service

Location

Date

Material

Amount

Total

Date

Amount

3/5/2020

4" PVC

cleanout

6" SDR 35

PVC pipe

6"-22° bend

6"-22° bend

10" Fernco

to existing


AC stub

depth @ 7'

DATE 3/5/2020

TOWN OF LEXINGTON — BOARD OF PUBLIC WORKS
SEWER DIVISION

Sketch of Service Here

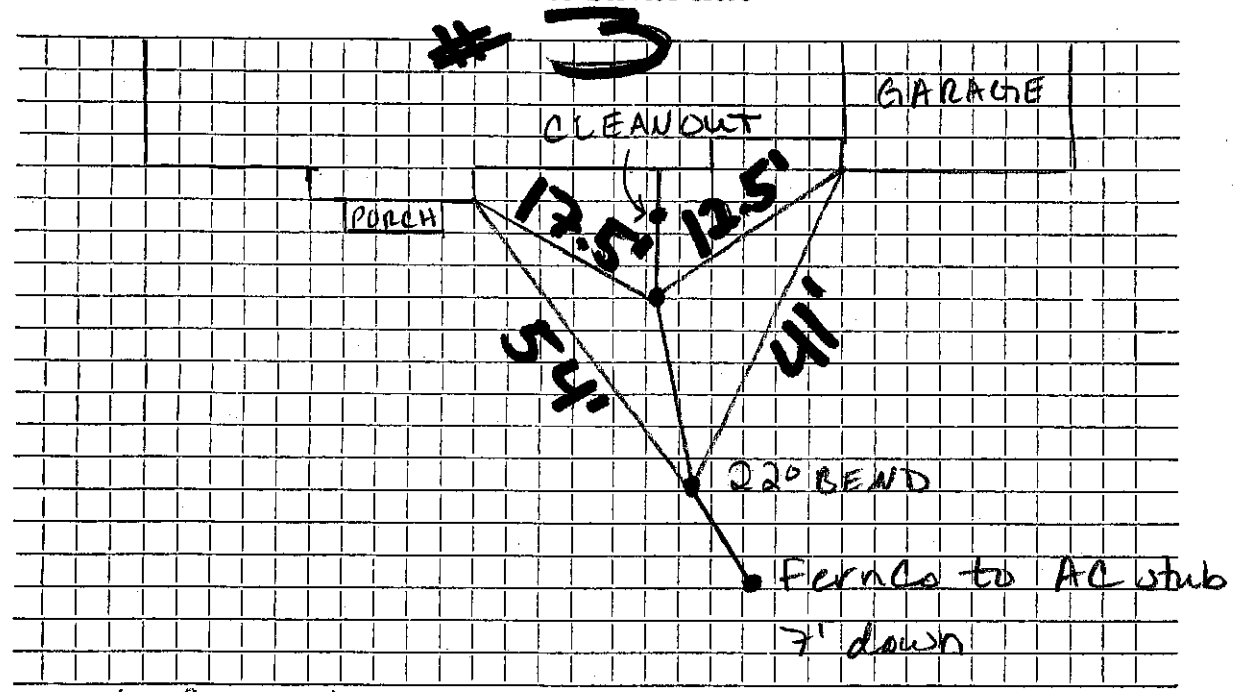

Connection made in ... Westwood Street. Work completed

Remarks:
.....
.....