

Name Melvin Frederick

Service No. 115

Address #16 Westwood Rd.

16 Westwood Road

Location

Kind of Pipe A.C.

Size 6"

Size of Main 8"

Repair—Renewal—New Service

Surianello #2343

Location NOV 19 1973


Date	Material	Amount	Total	Date		Amount
4/17/73	190' A.C. @ 9.00	\$171.00		9-15-77	Deposit	171.00
9/17/73	120' 6" Transite pipe					

DATE

TOWN OF LEXINGTON — BOARD OF PUBLIC WORKS

SEWER DIVISION

Sketch of Service Here **16**

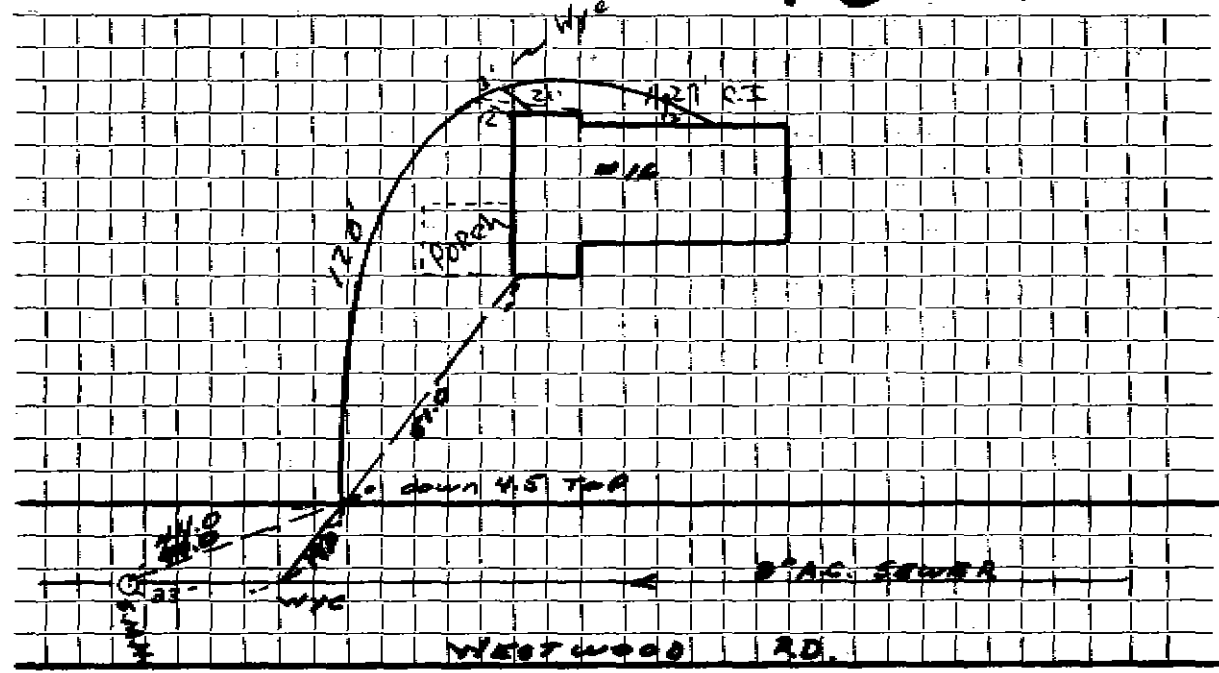

Connection made in Street. Work completed

Remarks:
.....
.....