

Name Edwin Cranston

Service No. 87

Address 4 Westwood Road

# 4 Westwood Rd.

4 Westwood Road

Location

Kind of Pipe

Size 6"

Size of Main 8"

JAN 27 1969

Repair—Renewal—New Service Valeri #1195


Location

Date	Material	Amount	Total	Date	Amount
57	27' 6" Transite pipe @ 6.00		162.00	9-18-68	162.00
3-68	39' 6" Transite pipe				
	10' 4" Cast Iron pipe				
	27' 6" Transite @ 6.00				

Deposit

TOWN OF LEXINGTON — BOARD OF PUBLIC WORKS  
SEWER DIVISION

Sketch of Service Here **4**

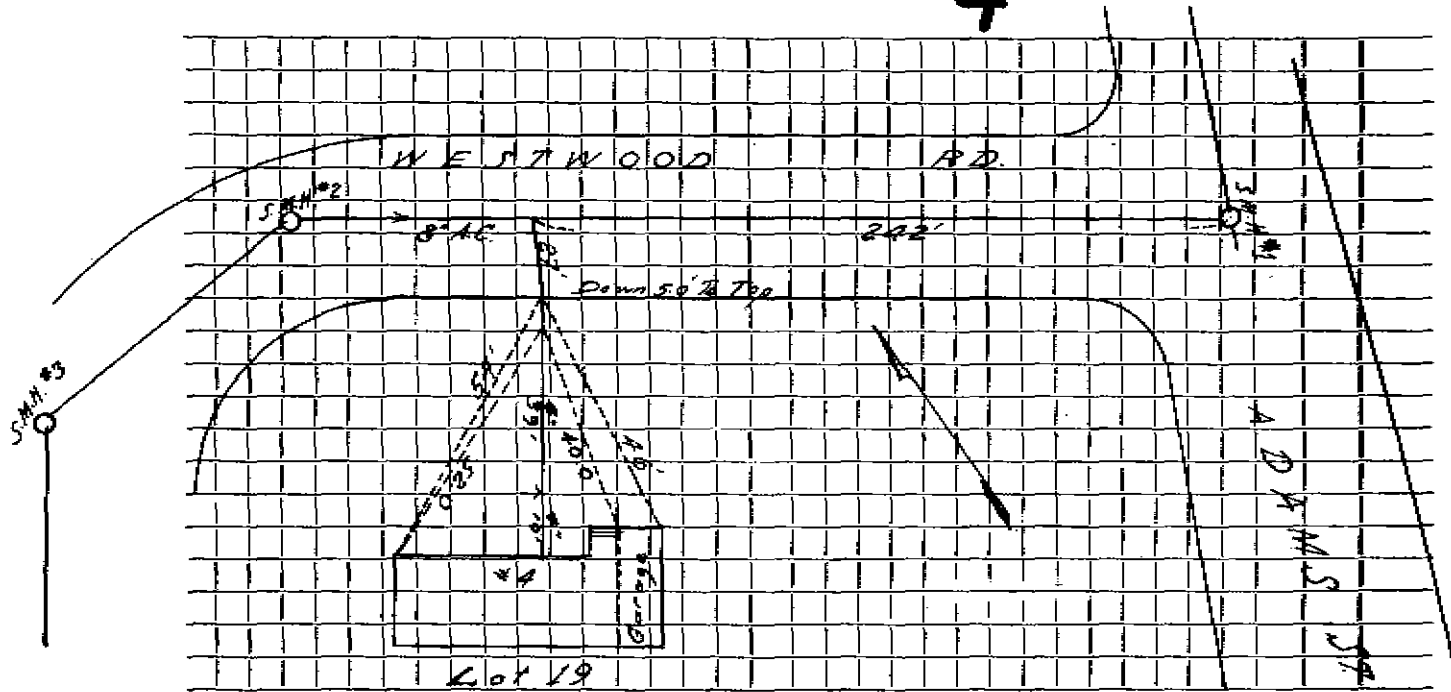

Connection made in ..... Street. Work completed .....

Remarks: .....

.....  
.....