

Name Mrs. Shirley Goodwin

Service No. 175

Address 5 Westwood Road

#5 Westwood Rd

5 Westwood Road

Location

Kind of Pipe 3"

Size

Size of Main

Repair—Renewal—New Service ~~12-6-67~~ Aldo #883

Location MAY 13 1968

Date	Material	Amount	Total	Date	Amount
67	31' 6" Transite pipe @6.00		186.00	11-24-67	186.00
-6-67	41' 6" Transite pipe				
	10' 4" Cast Iron pipe				
	31' 6" Transite	3.60			


*Deposit*

DATE \_\_\_\_\_

# TOWN OF LEXINGTON — BOARD OF PUBLIC WORKS

## SEWER DIVISION

Sketch of Service Here **5**

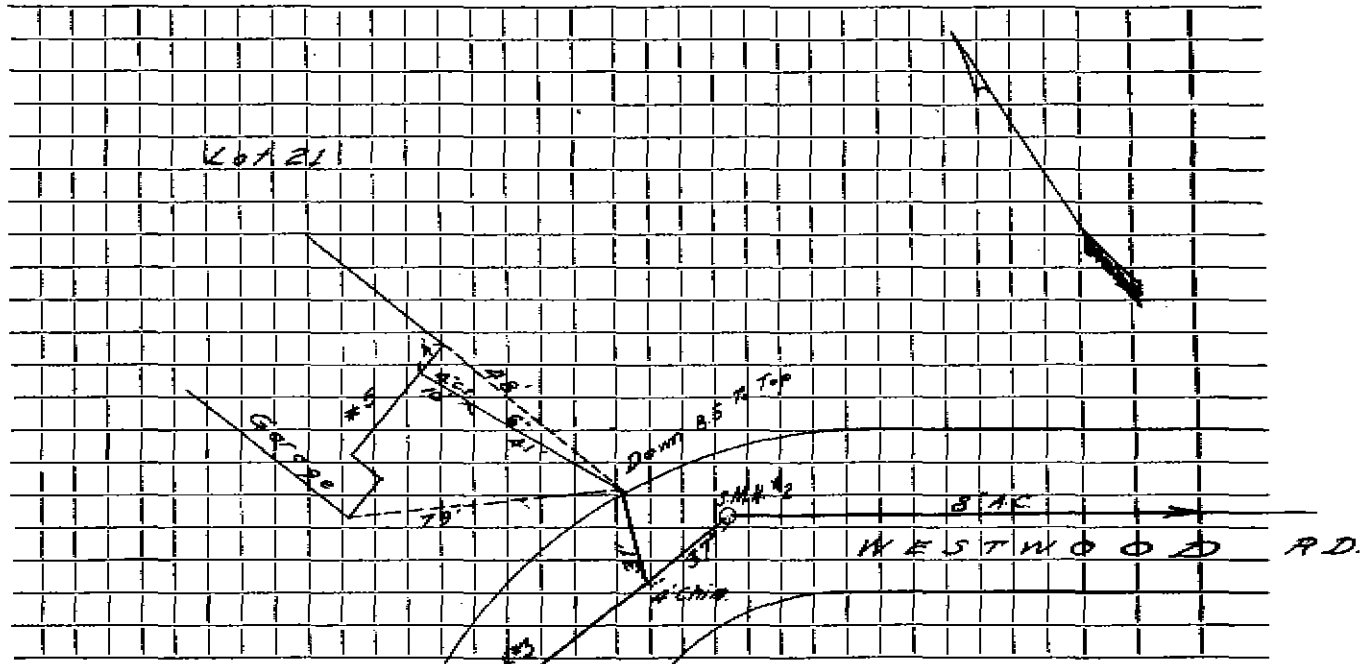

Connection made in .....

Remarks: .....

.....

.....