

Name George W. Catterall

Service No. 162

Address 7 Westwood Road

7 Westwood Rd.

7 Westwood Road

Location

Kind of Pipe 2"

Size 6"

Size of Main 8"

Repair—Renewal—New Service Aldo #845


Location MAY 13 1960

Date		Material	Amount	Total	Date		Amount
67	28'	6" Transite pipe @6.00		168.00	11/13/47	Deposit	168.00
-6-67	36'	6" Transite pipe					
	10'	4" Cast Iron pipe					
	28'	6" Transite @ 6.00					

DATE _____

TOWN OF LEXINGTON — BOARD OF PUBLIC WORKS
SEWER DIVISION

Sketch of Service Here **7**

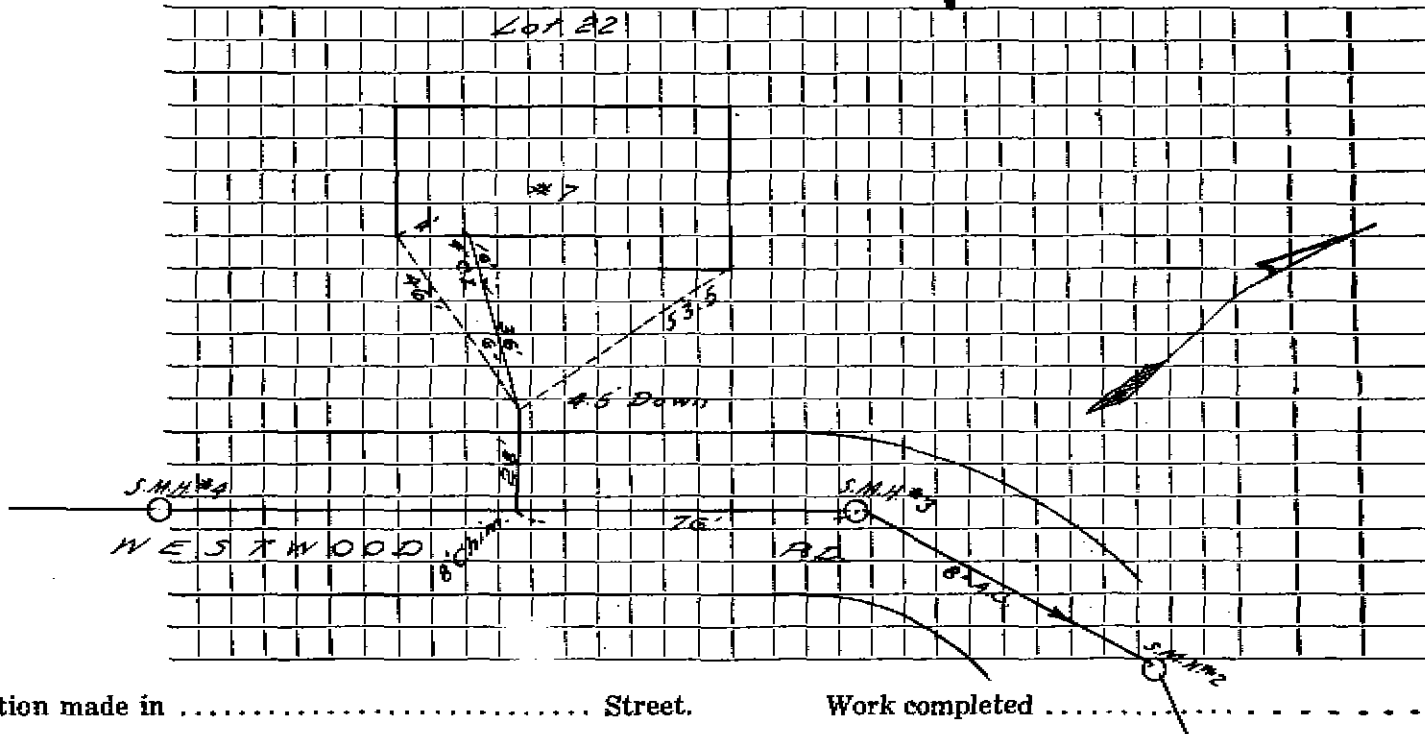

Connection made in Street. Work completed

Remarks:

.....

.....