

Name ~~XXXXXXXXXX~~ Bruce Brodsky

Service No. 106

Address 8 Westwood Road

8 Westwood Rd.

8 Westwood Road

Location

Kind of Pipe

Size 6"

Size of Main 8"

Repair—Renewal—New Service Lexington Sewerage #1947


Location JUN 5 1972

Date		Material	Amount	Total	Date		Amount
967	19'	6" Transite pipe @6.00		114.00	11-10-71	Deposit	114.00
L/15/71	30'	6" Transite pipe					
	10'	4" Cast Iron					
						OUTSIDE W.O.#198	
		19' 6" Transite	2 1/2 .00		1/17 & 3/15/79	Labor	
						1 2' x 6" Nipple	
						1 1' x 6" Nipple	
						1 90° Elbow	
						1 Transite Adapter	
						5 yds Gravel	
						1 1/2 Ton Cold Patch	
						Patch 12 x 7	
						11 hrs. Trucking	
						2 hrs. Compressor	
						2 hrs. Town Shovel	
						1/2 hr. Roller	

DATE _____

TOWN OF LEXINGTON — BOARD OF PUBLIC WORKS
SEWER DIVISION

Sketch of Service Here **8**

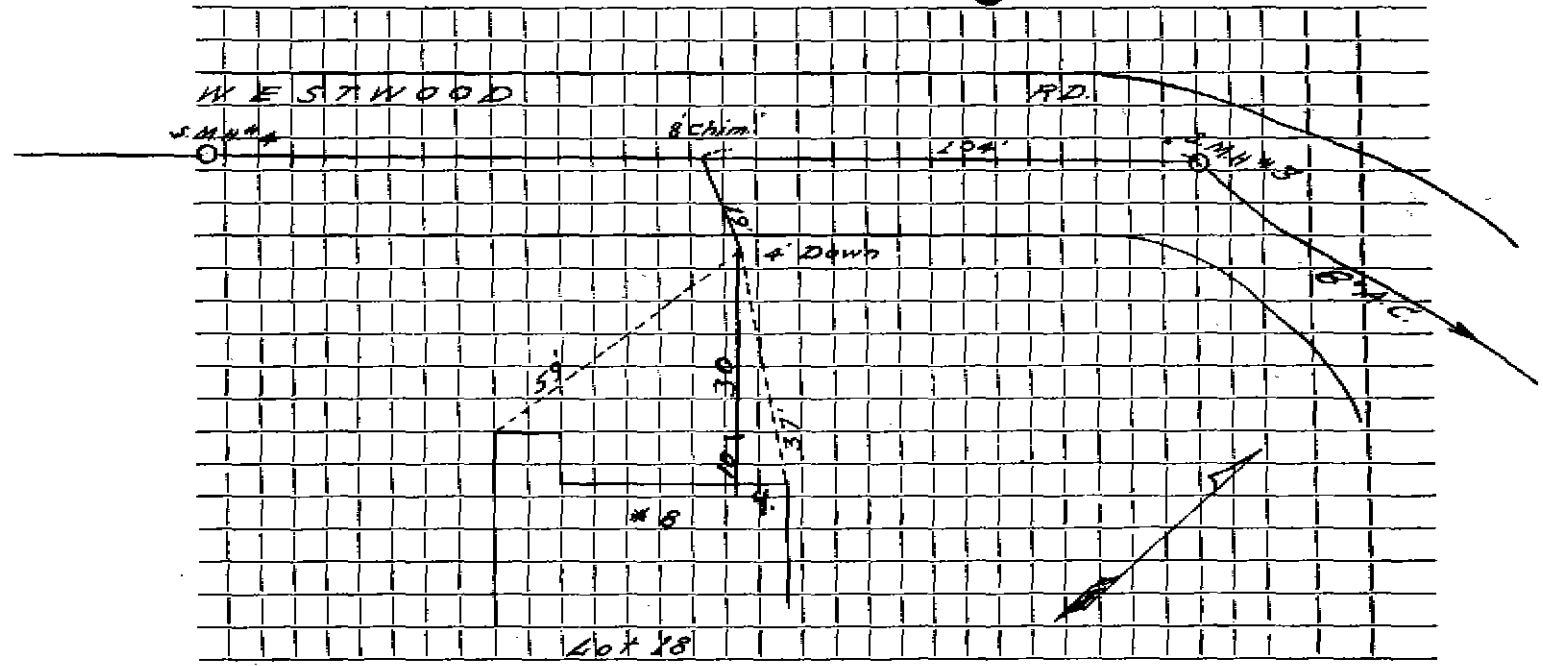

Connection made in Street. Work completed

Remarks:
.....
.....