

Name Harold L. Karshbaum

Service No. 169

Address 9 Westwood Road

# 9 Westwood Rd

9 Westwood Rd.

Location

Kind of Pipe 21

Size 6"

Size of Main 8"

Repair—Renewal—New Service Lexington Sewerage #964

Location MAY 13 1968

Date	Material	Amount	Total	Date	Amount
57	21' 6" Transite pipe @6.00		126.00	11-20-67	126.00
26-68	42' 6" Transite pipe				
	10' 4" Cast Iron pipe				
	21' 6" Transite @6.00				


Report

DATE \_\_\_\_\_

TOWN OF LEXINGTON — BOARD OF PUBLIC WORKS  
SEWER DIVISION

Sketch of Service Here

9

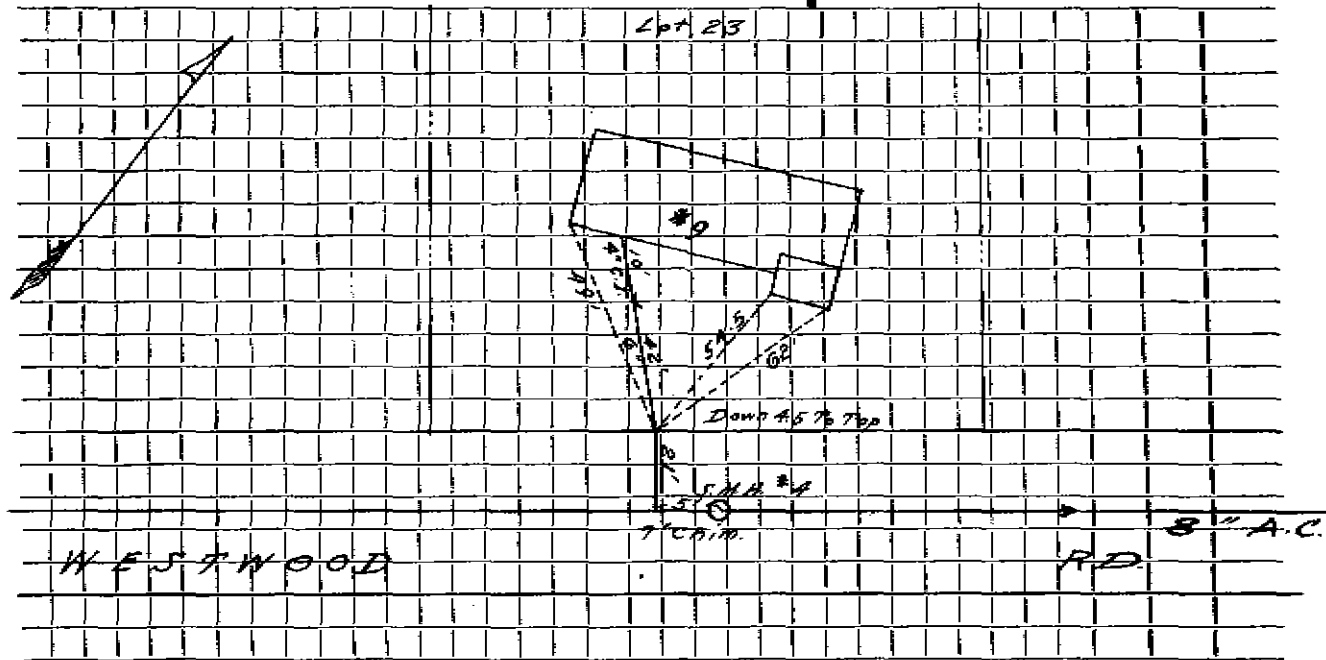

Connection made in ..... Street. Work completed .....

Remarks: .....

.....

.....