

Name DeVries Co.

Service No.

Address 11 Wheeler Rd.

11 Wheeler Road

Location

Kind of Pipe

Size 6"

Size of Main 8"

~~Repair~~—Renovation—New Service

Location

Date	Material	Amount	Total	Date	Amount
1954	INSTALLED BY DEVELOPER 75'				
	Labor				

**TOWN OF LEXINGTON—DEPT. OF PUBLIC WORKS**  
**SEWER DIVISION**

DATE.....

NO. ....


The undersigned applies for the construction of a particular sewer connecting No.....  
Street and hereby agrees to comply with the Rules and Regulations governing the construction and use of Particular  
Sewers, as now or at any future time established by the Board of Selectmen.

Am't of estimate \$.....

Am't Paid \$.....

..... Owner

**Sketch of Service Here**

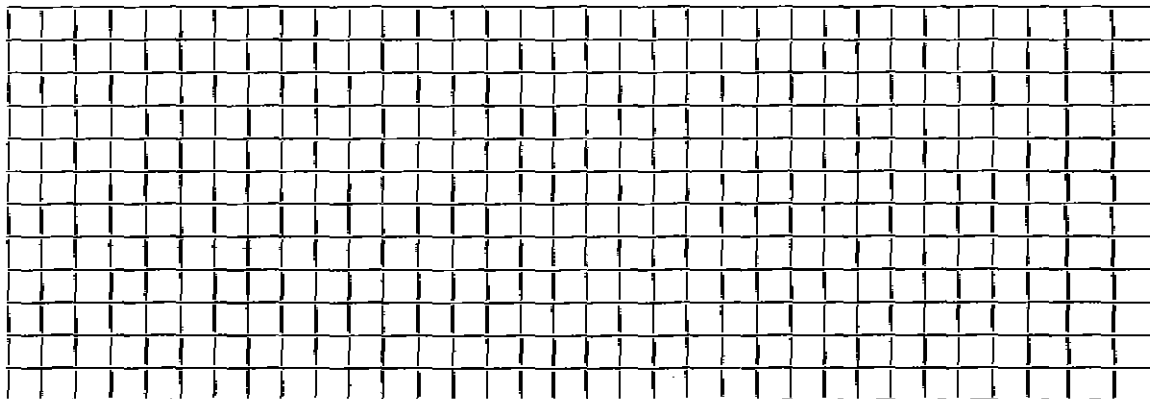

Connection made in..... Street.

Work completed..... 19..

Remarks: