

Name

Service No.

Address

21 Wheeler Rd

Location

Kind of Pipe

SDR35 PVC

Size

6"

Size of Main

Repair

~~Renewal~~

New Service

Location

Date

Material

Amount

Total

Date

Amount

5/11/21

6" PVC Cleanout

7/2/21


6" SDR35 PVC

6" SDR35 PVC

TOWN OF LEXINGTON — BOARD OF PUBLIC WORKS

SEWER DIVISION

Sketch of Service Here

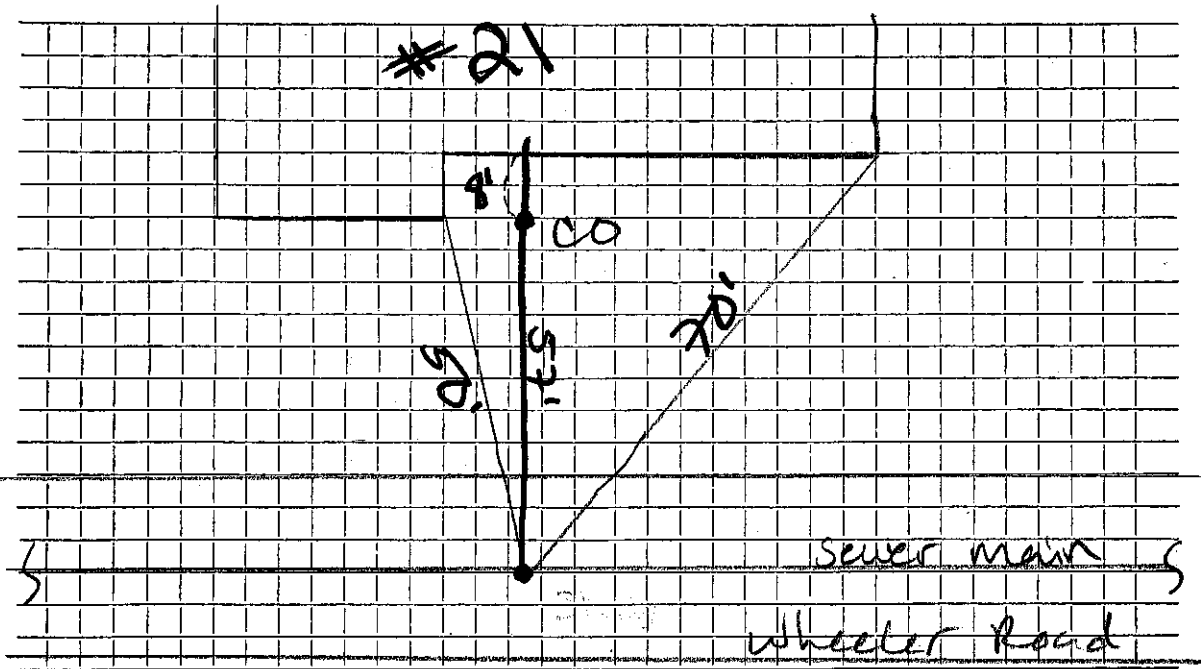

Connection made in Wheeler Rd Street. Work completed

Remarks: depth = 7'