

Name

Service No.

Address 157 LOWELL ST

Location

Kind of Pipe

Size

Size of Main

Repair ~~Renewal~~ New Service

Location

Date

Material

Amount

Total

Date

Amount

11/20/12

6" SDR

↓

6" CLEAN OUT

• 6" CAP

• 6" TEE WYE


• 6" SDR

45" PVC DEND

DATE 11/6/2012

TOWN OF LEXINGTON — BOARD OF PUBLIC WORKS
SEWER DIVISION

Sketch of Service Here

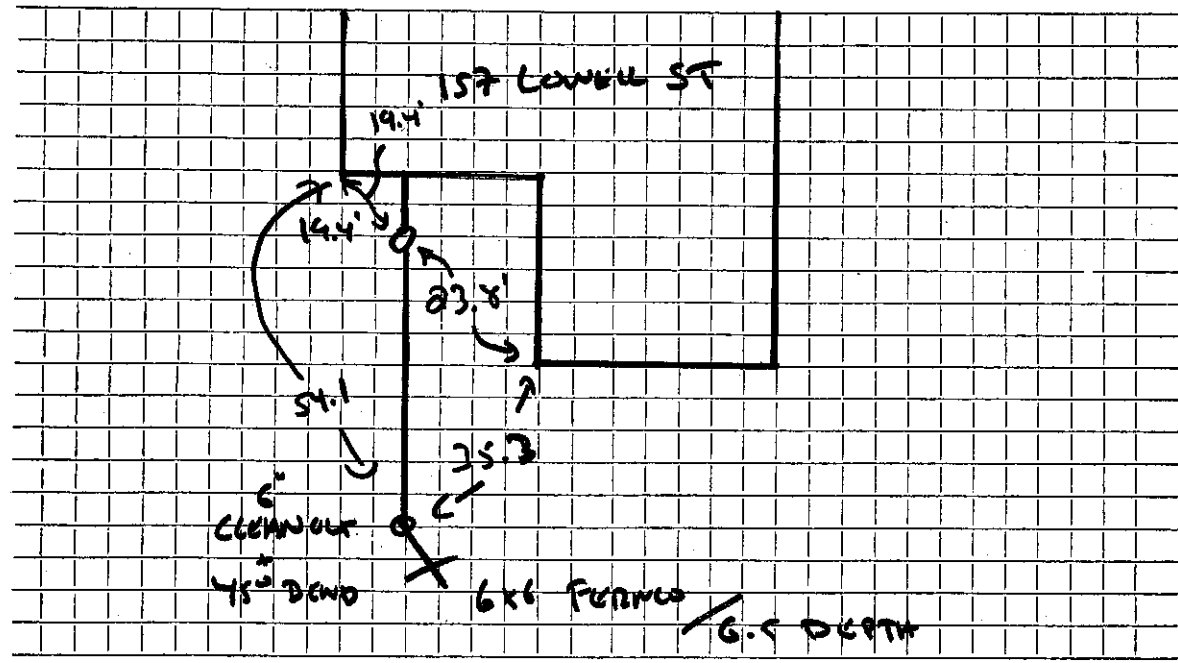

Connection made in LOWELL ST Street. Work completed by DAVID SANTO CONE

Remarks:

.....

.....